

## WATER WELL PLUGGING RECORD Form WWC-5P

KSA 82a-1212

ID NO.

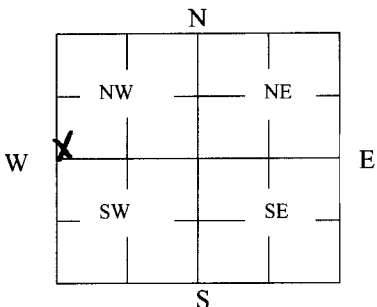
MW 2  
00172455

1 LOCATION OF WATER WELL: County: <u>Sedgwick</u>	Fraction <u>SW 1/4 NW 1/4</u>	Section Number <u>23</u>	Township Number <u>27</u>	Range Number <u>1</u> <u>EW</u>
--	-------------------------------	-----------------------------	------------------------------	------------------------------------

Distance and direction from nearest town or city street address of well if located within city?

162 N. Hillside Wichita, KS

2 WATER WELL OWNER: <u>Intrust Bank</u> RR#, St. Address, Box #: <u>P.O. Box 1</u> City, State ZIP Code: <u>Wichita, KS 67201</u>	Global Positioning Systems (decimal degrees, min. of 4 digits) Latitude: <u>37°N, 41' 16.851"</u> Longitude: <u>97°W, 17' 53.537"</u> Elevation: <u>1320</u> Datum: <u>NAD 27</u> Data Collection Method: <u>USGS Topo Map</u>
---	---

3 MARK WELL'S LOCATION WITH AN "X" IN SECTION BOX: 	4 DEPTH OF WELL <u>44</u> ft. WELL'S STATIC WATER LEVEL <u>37</u> ft. WELL WAS USED AS: <table border="0"> <tr> <td>1 Domestic</td> <td>5 Public Water Supply</td> <td>9 Dewatering</td> </tr> <tr> <td>2 Irrigation</td> <td>6 Oil Field Water Supply</td> <td><u>10</u> Monitoring</td> </tr> <tr> <td>3 Feedlot</td> <td>7 Domestic (Lawn &amp; Garden)</td> <td>11 Injection Well</td> </tr> <tr> <td>4 Industrial</td> <td>8 Air Conditioning</td> <td>12 Other</td> </tr> </table> Was a chemical/bacteriological sample submitted to Department? Yes <u>  </u> No <u>X</u>	1 Domestic	5 Public Water Supply	9 Dewatering	2 Irrigation	6 Oil Field Water Supply	<u>10</u> Monitoring	3 Feedlot	7 Domestic (Lawn & Garden)	11 Injection Well	4 Industrial	8 Air Conditioning	12 Other
1 Domestic	5 Public Water Supply	9 Dewatering											
2 Irrigation	6 Oil Field Water Supply	<u>10</u> Monitoring											
3 Feedlot	7 Domestic (Lawn & Garden)	11 Injection Well											
4 Industrial	8 Air Conditioning	12 Other											

5 TYPE OF BLANK CASING USED: 1 Steel <u>2</u> PVC 3 RMP (SR) 4 ABS 5 Wrought 6 Asbestos-Cement 7 Fiberglass 8 Concrete Tile 9 Other (Specify below)	Blank casing diameter <u>3</u> in. Was casing pulled? Yes <u>X</u> No <u>  </u> Casing height above or below <u>36</u> and surface <u>3 feet</u>
--	---

6 GROUT PLUG MATERIAL:	1 Neat cement	2 Cement grout	<u>3</u> Bentonite	4 Other																				
Grout Plug Intervals:	From <u>44</u> ft. to <u>3</u> ft.,	From <u>  </u> ft. to <u>  </u> ft.,	From <u>  </u> to <u>  </u> ft.																					
What is the nearest source of possible contamination: <table border="0"> <tr> <td>1 Septic tank</td> <td>6 Seepage pit</td> <td><u>11</u> Fuel Storage</td> <td>16 Other (specify below)</td> </tr> <tr> <td>2 Sewer lines</td> <td>7 Pit privy</td> <td>12 Fertilizer storage</td> <td></td> </tr> <tr> <td>3 Watertight sewer lines</td> <td>8 Sewage lagoon</td> <td>13 Insecticide storage</td> <td></td> </tr> <tr> <td>4 Lateral lines</td> <td>9 Feedyard</td> <td>14 Abandoned water well</td> <td>Direction from well? <u>Northeast</u></td> </tr> <tr> <td>5 Cess pool</td> <td>10 Livestock pens</td> <td>15 Oil well/Gas well</td> <td>How many feet? <u>45</u></td> </tr> </table>					1 Septic tank	6 Seepage pit	<u>11</u> Fuel Storage	16 Other (specify below)	2 Sewer lines	7 Pit privy	12 Fertilizer storage		3 Watertight sewer lines	8 Sewage lagoon	13 Insecticide storage		4 Lateral lines	9 Feedyard	14 Abandoned water well	Direction from well? <u>Northeast</u>	5 Cess pool	10 Livestock pens	15 Oil well/Gas well	How many feet? <u>45</u>
1 Septic tank	6 Seepage pit	<u>11</u> Fuel Storage	16 Other (specify below)																					
2 Sewer lines	7 Pit privy	12 Fertilizer storage																						
3 Watertight sewer lines	8 Sewage lagoon	13 Insecticide storage																						
4 Lateral lines	9 Feedyard	14 Abandoned water well	Direction from well? <u>Northeast</u>																					
5 Cess pool	10 Livestock pens	15 Oil well/Gas well	How many feet? <u>45</u>																					

FROM	TO	PLUGGING MATERIALS	FROM	TO	PLUGGING MATERIALS
<u>44</u>	<u>3</u>	<u>bentonite grout</u>			
<u>3</u>	<u>0</u>	<u>native material</u>			

7 CONTRACTOR'S OR LANDOWNER'S CERTIFICATION: This water well was plugged under my jurisdiction and was completed on (mo/day/year) <u>2/12/07</u> and this record is true to the best of my knowledge and belief. Kansas Water Well Contractor's License No. <u>544</u> . This Water Well Record was completed on (mo/day/year) <u>3/9/07</u> under the business name of <u>Coranco Great Plains, Inc.</u> by (signature) <u>Tony J. Mihal</u>
---

**INSTRUCTIONS:** Use typewriter or ballpoint pen. Please press firmly and print clearly. Please fill in blanks, underline or circle the correct answers. Send top three copies to Kansas Department of Health and Environment, Bureau of Water, Geology Section, 1000 SW Jackson St., Ste. 420, Topeka, Kansas 66612-1367. Telephone: 785/296-5522. Send one to Water Well Owner and retain one for your records. Visit us at <http://www.kdheks.gov/geo/waterwells>.