

1 LOCATION OF WATER WELL:		Fraction		Section Number		Township Number		Range Number	
County:	Sedgwick	SW ¼	SE ¼	SE ¼	4	T 27 S	R 1 E/W		


Distance and direction from nearest town or city street address of well if located within city?

1100 E. 21st St., Wichita

2] WATER WELL OWNER: El Paso Merchant Energy
RR#, St. Address, Box # : 2 North Nevada Ave.
City, State, ZIP Code : Colorado Springs, CO 80903

Board of Agriculture, Division of Water Resources
Application Number:

3] LOCATE WELL'S LOCATION
WITH AN "X" IN SECTION BOX:

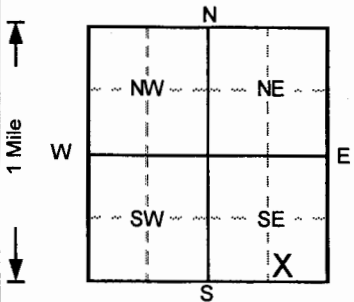

4 DEPTH OF COMPLETED WELL 25 ft. ELEVATION:

Depth(s) Groundwater Encountered 1. ft. 2. ft. 3. ft.

WELL'S STATIC WATER LEVEL ft. below land surface measured on mo/day/yr

Pump test data: Well water was NA ft. after hours pumping gpm

Est. Yield NA gpm: Well water was ft. after hours pumping gpm

Bore Hole Diameter 2 in. to 25 ft., and in. to ft.

WELL WATER TO BE USED AS:

5 Public water supply	8 Air conditioning	11 Injection well		
1 Domestic	3 Feedlot	6 Oil field water supply	9 Dewatering	12 Other (Specify below)
2 Irrigation	4 Industrial	7 Lawn and garden only	10 Monitoring ^{المص}	

Was a chemical/bacteriological sample submitted to Department? Yes.....No ☒ ..; If yes, mo/day/yr sample was submitted

Water Well Disinfected? Yes No ☒

5] TYPE OF BLANK CASING USED:

- 1 Steel 3 RMP (SR) 6 Asbestos-Cement 9 Other (specify below) Welded
- 2 PVC 4 ABS 7 Fiberglass Threaded. ☒

Blank casing diameter **2** . . . in. to . . . **10** . . . ft, Dia in. to ft, Dia in. to ft
Casing height above land surface **36** . . . in, weight lbs./ft. Wall thickness or gauge No. **Sch. 40**

TYPE OF SCREEN OR PERFORATION MATERIAL

- | | | | | |
|---------|--------------------|-----------------|------------|------------------------------|
| 1 Steel | 3 Stainless steel | 5 Fiberglass | 8 RMP (SR) | 11 Other (specify) |
| 2 Brass | 4 Galvanized steel | 6 Concrete tile | 9 ABS | 12 None used (open hole) |

SCREEN OR PERFORATION OPENINGS ARE:

- 1 Continuous slot **3** Mill slot 6 Wire wrapped 9 Drilled holes
2 Louvered shutter 4 Key punched 7 Torch cut 10 Other (specify)

SCREEN-PERFORATED INTERVALS: From 10 ft. to 25 ft. From _____ ft. to _____ ft.
From _____ ft. to _____ ft. From _____ ft. to _____ ft.

GRAVEL PACK INTERVALS: From 7.5 ft to 25 ft, From ft to ft
From ft to ft, From ft to ft

6 GROUT MATERIAL:

Grout Intervals: From 2.5 ft. to 7.5 ft., From ft. to ft., From ft. to ft.

What is the nearest source of possible contamination:

- | | | | | |
|--------------------------|-----------------|-----------------|------------------------|--------------------------|
| 1 Septic tank | 4 Lateral lines | 7 Pit privy | 11 Fuel storage | 15 Oil well/Gas well |
| 2 Sewer lines | 5 Cess pool | 8 Sewage lagoon | 12 Fertilizer storage | 16 Other (specify below) |
| 3 Watertight sewer lines | 6 Seepage pit | 9 Feedyard | 13 Insecticide storage | |

Direction from well?

FROM	TO	LITHOLOGIC LOG	FROM	TO	PLUGGING INTERVALS
0	8	Clay, silty, Dark Brown			
8	25	Gravel, non-native (placed for trench),			
					PZ13 , Abovegrade
					Project Name: CDM - El Paso Refinery, Wichita
					GeoCore # 1353 , #

7 CONTRACTOR'S OR LANDOWNER'S CERTIFICATION: This water well was (1) constructed, (2) reconstructed, or (3) plugged under my jurisdiction and was completed on (mo/day/year) 3/16/2007 and this record is true to the best of my knowledge and belief.
Kansas Water Well Contractor's License No. 527 This Water Well Record was completed on (mo/day/yr) 3/19/2007
under the business name of GeoCore, Inc. by (signature) [Signature]