

1) LOCATION OF WATER WELL:		Fraction		Section Number		Township Number		Range Number	
County:	Sedgwick	SW ¼	SE ¼	SE ¼	4	T 27 S	R 1	E/W	


Distance and direction from nearest town or city street address of well if located within city?

1100 E. 21st St., Wichita

2 WATER WELL OWNER: El Paso Merchant Energy
RR#, St. Address, Box # : 2 North Nevada Ave.
City, State, ZIP Code : Colorado Springs, CO 80903

Board of Agriculture, Division of Water Resources
Application Number:

3 LOCATE WELL'S LOCATION
WITH AN "X" IN SECTION BOX:

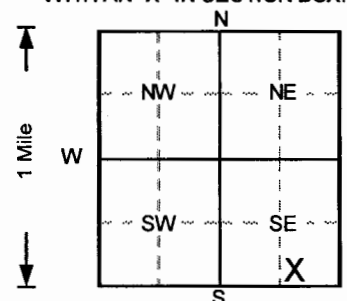

4 DEPTH OF COMPLETED WELL 25 ft. ELEVATION:
 Depth(s) Groundwater Encountered 1. ft. 2. ft. 3. ft.
 WELL'S STATIC WATER LEVEL ft. below land surface measured on mo/day/yr
 Pump test data: Well water was NA ft. after hours pumping gpm
 Est. Yield .. NA .. gpm: Well water was ft. after hours pumping gpm
 Bore Hole Diameter 8 in. to 25 ft., and in. to ft.
 WELL WATER TO BE USED AS: 5 Public water supply 8 Air conditioning 11 Injection well
 1 Domestic 3 Feedlot 6 Oil field water supply 9 Dewatering 12 Other (Specify below)
 2 Irrigation 4 Industrial 7 Lawn and garden only 10 Monitoring ^{المراقبة}
 Was a chemical/bacteriological sample submitted to Department? Yes.....No✓...; If yes, mo/day/yr sample was submitted
 Water Well Disinfected? Yes No✓

5 TYPE OF BLANK CASING USED:

5 Wrought iron	8 Concrete tile	CASING JOINTS: Glued Clamped
6 Asbestos-Cement	9 Other (specify below)	Welded
7 Fiberglass		Threaded. <input checked="" type="checkbox"/>

Blank casing diameter **2** in. to **10** ft. Dia in. to ft. Dia in. to ft.
Casing height above land surface **36** in. weight lbs./ft. Wall thickness or gauge No. . . . **Sch. 40**

TYPE OF SCREEN OR PERFORATION MATERIAL

5 Fiberglass	7 PVC	10 Asbestos-cement
6 Concrete tile	8 RMP (SR)	11 Other (specify)
	9 ABS	12 None used (open hole)

SCREEN OR PERFORATION OPENINGS ARE:

5 Gauzed wrapped 8 Saw cut 11 None (open hole)
6 Wire wrapped 9 Drilled holes
7 Torch cut 10 Other (specify)

SCREEN-PERFORATED INTERVALS: From 10 ft to 25 ft, From ft to ft
From ft to ft, From ft to ft
GRAVEL PACK INTERVALS: From 7 ft to 25 ft, From ft to ft
From ft to ft, From ft to ft

6 GROUT MATERIAL: 1 Neat cement 2 Cement grout 3 Bentonite 4 Other

Grout Intervals: From 2.5 ft to 7 ft From ft to ft From ft to ft

What is the nearest source of possible contamination:

1 Septic tank	4 Lateral lines	7 Pit privy	11 Fuel storage	15 Oil well/Gas well
2 Sewer lines	5 Cess pool	8 Sewage lagoon	12 Fertilizer storage	16 Other (specify below)
3 Watertight sewer lines	6 Seepage pit	9 Feedyard	13 Insecticide storage

Direction from well?

How many feet?

FROM	TO	LITHOLOGIC LOG	FROM	TO	PLUGGING INTERVALS
0	8	Clay, silty, Dark Brown			
8	25	Gravel, non-native (placed for trench),			
					PZ16 , Abovegrade
					Project Name: CDM - El Paso Refinery, Wichita
					GeoCore # 1353 . #

7 CONTRACTOR'S OR LANDOWNER'S CERTIFICATION: This water well was (1) constructed, (2) reconstructed, or (3) plugged under my jurisdiction and was completed on (mo/day/year) 3/16/2007 and this record is true to the best of my knowledge and belief.
Kansas Water Well Contractor's License No. 527. This Water Well Record was completed on (mo/day/yr) 3/19/2007.
under the business name of GeoCore, Inc. by signature [Signature]