

1	LOCATION OF WATER WELL:	Fraction	Section Number	Township Number	Range Number
	County: <u>Sedgwick</u>	<u>SE 1/4 SE 1/4 SW 1/4</u>	<u>26</u>	<u>27S</u>	<u>1</u> <u>EW</u>

Distance and direction from nearest town or city street address of well if located within city?

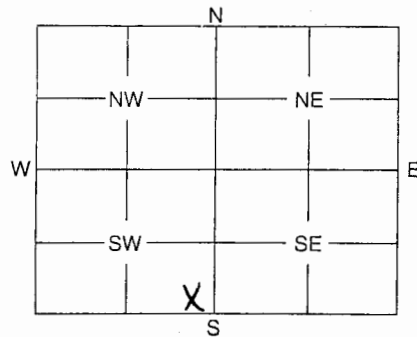
3938 E. Harry St., Wichita, Kansas2 WATER WELL OWNER: BFS Retail and Commercial Operations, LLCRR #, St. Address, Box #: 333 E. Lake St.

Board of Agriculture, Division of Water Resources

City, State, ZIP Code: Bloomington, IL 61808

Application Number:

3 MARK WELL'S LOCATION WITH AN "X" IN SECTION BOX:

4 DEPTH OF WELL 24.30 ft.WELL'S STATIC WATER LEVEL 21.14 ft.

WELL WAS USED AS:

- 1 Domestic
- 2 Irrigation
- 3 Feedlot
- 4 Industrial

- 5 Public Water Supply
- 6 Oil Field Water Supply
- 7 Domestic (Lawn & Garden)
- 8 Air Conditioning

- 9 Dewatering
- 10 Monitoring Well
- 11 Injection Well
- 12 Other

Was a chemical / bacteriological sample submitted to Department? Yes No ☒

If yes, mo/day/yr sample was submitted

Water Well Disinfected: Yes No ☒

5 TYPE OF BLANK CASING USED:

- 1 Steel
- 2 PVC
- 3 RMP (SR)
- 4 ABS
- 5 Wrought
- 6 Asbestos-Cement
- 7 Fiberglass
- 8 Concrete Tile
- 9 Other (Specify below)

Blank casing diameter 2 in.Was casing pulled? Yes No ☒

If yes, how much

Casing height above or below land surface 36 in.6 GROUT PLUG MATERIAL: 1 Neat cement 2 Cement grout 3 Bentonite 4 OtherGrout Plug Intervals: From 3 ft. to 24.30 ft., From ft. to ft., From ft. to ft.

What is the nearest source of possible contamination:

- 1 Septic tank
- 2 Sewer lines
- 3 Watertight sewer lines
- 4 Lateral lines
- 5 Cess pool
- 6 Seepage pit
- 7 Pit privy
- 8 Sewage lagoon
- 9 Feedyard
- 10 Livestock pens
- 11 Fuel storage
- 12 Fertilizer storage
- 13 Insecticide storage
- 14 Abandoned water well
- 15 Oil well/Gas well

16 Other (specify below)

Former UST Basin
3938 E. Harry St.Direction from well? EastHow many feet? 6

FROM	TO	PLUGGING MATERIALS
<u>3</u>	<u>24.30</u>	<u>Bentonite</u>
<u>0.5</u>	<u>3</u>	<u>Top Soil</u>
<u>0</u>	<u>0.5</u>	<u>Asphalt</u>

CORRECTED

7 CONTRACTOR'S OF LANDOWNER'S CERTIFICATION: This water well was plugged under my jurisdiction and was completed on (mo/day/year) 12/19/07 and this record is true to the best of my knowledge and belief. Kansas Water Well Contractor's License No. 416 This Water Well Record was completed on (mo/day/year) 11/7/08 under the business name of Terracon Consultants, Inc. by (signature) [Signature]

INSTRUCTIONS: Use typewriter or ball point pen. Please press firmly and print clearly. Please fill in blanks, underline or circle the correct answers. Send top three copies to Kansas Department of Health and Environment, Bureau of Water, Geology Section, 1000 SW Jackson St., Ste. 420, Topeka, Kansas 66612-1367. Telephone: 785/296-5522. Send one to Water Well Owner and retain one for your records.