


**527 W. 13<sup>th</sup> St., Wichita**

RR#, St. Address, Box # : **2 N. Nevada**  
City, State, ZIP Code : **Colorado Springs, CO 80903**

Board of Agriculture, Division of Water Resources  
Application Number:

4	DEPTH OF COMPLETED WELL	27	ft. ELEVATION:
---	-------------------------	----	----------------

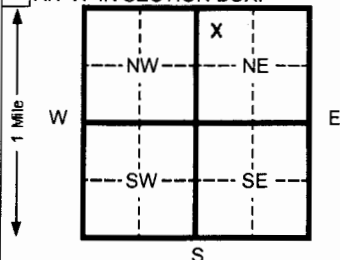

4 DEPTH OF COMPLETED WELL		27		ft. ELEVATION:	
Depth(s) Groundwater Encountered		1	15.14	ft. 2	ft. 3
WELL'S STATIC WATER LEVEL		ft. below land surface measured on mo/day/yr			
Pump test data:		Well water was	ft. after	hours pumping	gpm
Est. Yield		gpm: Well water was	ft. after	hours pumping	gpm
Bore Hole Diameter		8.25	in. to	27	ft. and in. to ft.
WELL WATER TO BE USED AS:		5 Public water supply	8 Air conditioning	11 Injection well	
1 Domestic	3 Feed lot	6 Oil field water supply	9 Dewatering	12 Other (Specify below)	
2 Irrigation	4 Industrial	7 Lawn and garden (domestic)	10 Monitoring well		Air Sparge
Was a chemical/bacteriological sample submitted to Department? Yes No <input checked="" type="checkbox"/> If yes, mo/day/yr sample was submitted					
Water Well Disinfected? Yes No <input checked="" type="checkbox"/>					

5 TYPE OF BLANK CASING USED:			5 Wrought Iron	8 Concrete tile	CASING JOINTS: Glued _____ Clamped _____
1 Steel	3 RMP (SR)		6 Asbestos-Cement	9 Other (specify below)	Welded _____
2 PVC	4 ABS		7 Fiberglass		Threaded _____ Flush _____

Blank casing diameter	<b>2</b>	in. to	<b>25</b>	ft., Dia	in. to	ft., Dia	in. to	ft.
Casing height above land surface	<b>Flushmount</b>	in., weight	<b>0.703</b>	lbs./ft.	Wall thickness or gauge No.	<b>SCH. 40</b>		

TYPE OF SCREEN OR PERFORATION MATERIAL:					
1 Steel	3 Stainless steel	5 Fiberglass	7 PVC	10 Asbestos-cement	
2 Brass	4 Galvanized steel	6 Concrete tile	8 RMP (SR)	11 Other (specify)	
			9 ABS	12 None used (open hole)	

SCREEN OR PERFORATION OPENINGS ARE:

1 Continuous slot	3 Mill slot	5 Gauzed wrapped	8 Saw cut	11 None (open hole)
2 Louvered shutter	4 Key punched	6 Wire wrapped	9 Drilled holes	
		7 Torch cut	10 Other (specify)	


SCREEN-PERFORATED INTERVALS:	From	<b>25</b>	ft. to	<b>27</b>	ft. From		ft. to		ft.
	From		ft. to		ft. From		ft. to		ft.
GRAVEL PACK INTERVALS:	From	<b>23.9</b>	ft. to	<b>27</b>	ft. From		ft. to		ft.
	From		ft. to		ft. From		ft. to		ft.

6	GROUT MATERIAL:		1 Neat cement	2 Cement grout	<b>3 Bentonite</b>	4 Other
	Grout Intervals	From	<b>3</b> ft to	<b>23.9</b> ft From	ft to	ft From ft to ft

From	To	From	To	From	To
What is the nearest source of possible contamination:					
1 Septic tank	4 Lateral lines	7 Pit privy	10 Livestock pens	14 Abandoned water well	
2 Sewer lines	5 Cess pool	8 Sewage lagoon	11 Fuel storage	15 Oil well/ Gas well	
3 Watertight sewer lines	6 Seepage pit	9 Feedyard	12 Fertilizer storage	16 Other (specify below)	
			13 Insecticide storage		

Direction from well? \_\_\_\_\_ How many feet? \_\_\_\_\_

[illegible]

7 CONTRACTOR'S OR LANDOWNER'S CERTIFICATION: This water well was (1) constructed, (2) reconstructed, or (3) plugged under my jurisdiction and was completed on (mo/day/yr) **11/20/07** and this record is true to the best of my knowledge and belief. Kansas Water Well Contractor's License No. **531** This Water Well Record was completed on (mo/day/yr) **02/07/08** under the business name of **Geotechnical Services Inc.** by (signature) 

INSTRUCTIONS: Please fill in blanks and circle the correct answers. Send three copies to Kansas Department of Health and Environment, Bureau of Water, 1000 S W Jackson St., Ste. 420, Topeka, Kansas 66612-1367. Telephone: 913-296-5545. Send one to WATER WELL OWNER and retain one for your records.