


**527 W. 13<sup>th</sup> St., Wichita**

Application Number:

4	DEPTH OF COMPLETED WELL	17	ft. ELEVATION:
---	-------------------------	----	----------------

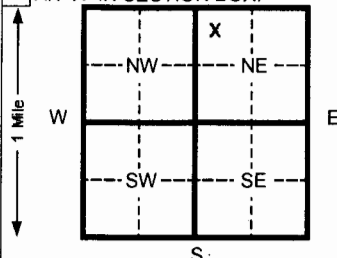

Depth(s) Groundwater Encountered	1	<b>15.15</b>	ft.	2		ft.	3		ft.
----------------------------------	---	--------------	-----	---	--	-----	---	--	-----

Pump test data:	Well water was	ft. after	hours pumping	gpm
-----------------	----------------	-----------	---------------	-----

Pump test data: Well water was \_\_\_\_\_ ft. after \_\_\_\_\_ hours pumping \_\_\_\_\_ gpm

Est. Yield	gpm:	Well water was	ft. after	hours pumping	gpm
------------	------	----------------	-----------	---------------	-----

Bore Hole Diameter **10** in. to **17** ft. and in. to ft.

WELL WATER TO BE USED AS: 5 Public water supply 8 Air conditioning 11 Injection well

1 Domestic	3 Feed lot	6 Oil field water supply	9 Dewatering	12 <b>Other</b> (Specify below)
------------	------------	--------------------------	--------------	---------------------------------

2 Irrigation	4 Industrial	7 Lawn and garden (domestic)	10 Monitoring well	<b>Soil Vapor Extraction</b>
--------------	--------------	------------------------------	--------------------	------------------------------

Was a chemical/bacteriological sample submitted to Department? Yes No **X** If yes, mo/day/yr sample was

submitted Water Well Disinfected? Yes No **X**

5	Wrought Iron	8	Concrete tile	CASING JOINTS: Glued	Clamped
---	--------------	---	---------------	----------------------	---------

6 Asbestos-Cement      9 Other (specify below)

## 7 Fiberglass

Steel		Fiberglass		Infrared		Infrared	
Blank casing diameter	4 in. to 7 ft. Dia	in. to	ft. Dia	in. to	ft. Dia	in. to	ft.

Casing height above land surface	<b>Flushmount</b>	in., weight	<b>0.703</b>	lbs./ft. Wall thickness or gauge No.	<b>SCH. 40</b>
----------------------------------	-------------------	-------------	--------------	--------------------------------------	----------------

TYPE OF SCREEN OR PERFORATION MATERIAL:

1 Steel                      3 Stainless steel                      5 Fiberglass                      8 RMP (SR)                      11 Other (specify)

2 Brass	4 Galvanized steel	6 Concrete tile	9 ABS	12 None used (open hole)
---------	--------------------	-----------------	-------	--------------------------

EEEN OR PERFORATION OPENINGS ARE:                      5   Gauzed wrapped                      8   Saw cut                      11   None (open hole)

1 Continuous slot	<b>3 Mill slot</b>	6 Wire wrapped	9 Drilled holes
2 Louvered shutter	4 Key punched	7 Torch cut	10 Other (specify)

SCREEN-PERFORATED INTERVALS: From **7** ft. to **17** ft. From \_\_\_\_\_ ft. to \_\_\_\_\_ ft.

	ft.	to	ft.		ft.	to	ft.	
--	-----	----	-----	--	-----	----	-----	--

GRAVEL PACK INTERVALS: From **5.5** ft. to **17** ft. From                      ft. to                      ft.

	ft.	to	ft.		ft.	to	ft.	
From				From				

6	GROUT MATERIAL:	1 Neat cement	2 Cement grout	3 Bentonite	4 Other
---	-----------------	---------------	----------------	-------------	---------

Grout Intervals		From		ft. to		ft. From		ft. to		ft. From		ft. to		ft.	
		3				5.5									

What is the nearest source of possible contamination:	10	14
Livestock pens		Abandoned water well

1	Septic tank	4	Lateral lines	7	Pit privy	11	Fuel storage	15	Oil well/ Gas well
---	-------------	---	---------------	---	-----------	----	--------------	----	--------------------

2 Sewer lines	5 Cess pool	8 Sewage lagoon	12 Fertilizer storage	16 Other (specify below)
---------------	-------------	-----------------	-----------------------	--------------------------

3 Watertight sewer lines	6 Seepage pit	9 Feedyard	13 Insecticide storage
--------------------------	---------------	------------	------------------------

Direction from well? \_\_\_\_\_ How many feet? \_\_\_\_\_

FROM	TO	CODE	LITHOLOGIC LOG	FROM	TO	PLUGGING INTERVALS
------	----	------	----------------	------	----	--------------------

0	17	Sand, dark brown to tan, fine to medium grained, silty between 0' and 5'
---	----	--

[illegible]

7. CONTRACTOR'S OR LANDOWNER'S CERTIFICATION: This water well was (1) constructed, (2) reconstructed, or (3) plugged under my jurisdiction and was completed on (mo/day/yr) 11/21/07 and this record is true to the best of my knowledge and belief. Kansas

Water Well Contractor's License No. **531** This Water Well Record was completed on (mo/day/yr) **02/07/08**

under the business name of **Geotechnical Services Inc.** by (signature) \_\_\_\_\_

INSTRUCTIONS: Please fill in blanks and circle the correct answers. Send three copies to Kansas Department of Health and Environment, Bureau of Water, 1000 S W Jackson St., Ste. 420, Topeka, Kansas 66612-1367. Telephone: 913-296-5545. Send one to WATER WELL OWNER and retain one for your records.