


1 LOCATION OF WATER WELL:	Fraction	Section Number	Township Number	Range Number
County: Sedgwick	NW ¼ NW ¼ SW ¼	20	T 27 S	R 1 E

Distance and direction from nearest town or city street address of well if located within city?

206 N. Seneca Street, Wichita, Ks

2 WATER WELL OWNER: Estfan LLC	Board of Agriculture, Division of Water Resources
RR#, St. Address, Box #: 206 S. Seneca	Application Number:
City, State, ZIP Code: Wichita, Ks 67203	

3 LOCATE WELL'S LOCATION WITH AN "X" IN SECTION BOX:

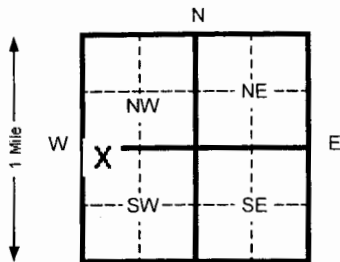

4 DEPTH OF COMPLETED WELL	23 ft.	ELEVATION:
Depth(s) Groundwater Encountered	11.5 ft.	2 ft. 3 ft.
WELL'S STATIC WATER LEVEL	16.70 ft. below land surface measured on	01/10/08
Pump test data:	Well water was	Ft. after
Est. Yield	Gpm: Well water was	Hours pumping
Bore Hole Diameter	8.625 in. to 23 ft. and	in. to
WELL WATER TO BE USED AS:	5 Public water supply	8 Air conditioning
1 Domestic	3 Feed lot	6 Oil field water supply
2 Irrigation	4 Industrial	7 Lawn and garden (domestic)
10 Monitoring well		MW-8
Was a chemical/bacteriological sample submitted to Department? Yes	No X	If yes, mo/day/yr sample was
Submitted	Water Well Disinfected? Yes	No X

5 TYPE OF BLANK CASING USED:	5 Wrought Iron	8 Concrete tile	CASING JOINTS: Glued	Clamped
1 Steel	3 RMP (SR)	6 Asbestos-Cement	9 Other (specify below)	Welded
2 PVC	4 ABS	7 Fiberglass	Threaded	X
Blank casing diameter	2 ft.	4 ft.	13 ft.	
Casing height above land surface	FLUSH	In., weight	SCH 40	Lbs./ft. Wall thickness or gauge No.
TYPE OF SCREEN OR PERFORATION MATERIAL:	7 PVC	10 Asbestos-cement		
1 Steel	3 Stainless steel	5 Fiberglass	8 RMP (SR)	11 Other (specify)
2 Brass	4 Galvanized steel	6 Concrete tile	9 ABS	12 None used (open hole)
SCREEN OR PERFORATION OPENINGS ARE:	5 Gauzed wrapped	8 Saw cut	11 None (open hole)	
1 Continuous slot	3 Mill slot	6 Wire wrapped	9 Drilled holes	
2 Louvered shutter	4 Key punched	7 Torch cut	10 Other (specify)	
SCREEN-PERFORATED INTERVALS:	From 13 ft. to 23 ft.	From	ft. to	ft.
SAND PACK INTERVALS:	From 12 ft. to 23 ft.	From	ft. to	ft.

6 GROUT MATERIAL:	1 Neat cement	2 Cement grout	3 Bentonite	4 Other
Grout Intervals	From 0 ft. to 10 ft.	From 10 ft. to 12 ft.	From	ft. to
What is the nearest source of possible contamination:	1 Septic tank	4 Lateral lines	7 Pit privy	10 Livestock pens
2 Sewer lines	5 Cess pool	8 Sewage lagoon	12 Fertilizer storage	14 Abandoned water well
3 Watertight sewer lines	6 Seepage pit	9 Feedyard	13 Insecticide storage	15 Oil well/ Gas well
Direction from well?				Contaminated Site
How many feet?				

FROM	TO	CODE	LITHOLOGIC LOG	FROM	TO	PLUGGING INTERVALS
0	1		Soil, dark brown clay loam			
1	6.5		Clayey Silt (ML) brown			
6.5	9.5		Silty clay (CL)			
9.5	23		Sand (Sw) brown fine-medium			
23	TD		End of Borehole			

7 CONTRACTOR'S OR LANDOWNER'S CERTIFICATION: This water well was (x) constructed, (2) reconstructed, or (3) plugged under my jurisdiction and	Completed on (mo/day/yr) 01/10/08	And this record is true to the best of my knowledge and belief. Kansas
Water Well Contractor's License No. 585	This Water Well Record was completed on (mo/day/yr) 02/08/08	
under the business name of Associated Environmental, Inc.	By (signature) Bradley Johnson	
INSTRUCTIONS: Please fill in blanks and circle the correct answers. Send three copies to Kansas Department of Health and Environment, Bureau of Water, Topeka, Kansas 66620-0001. Telephone: 913-296-5545. Send one to WATER WELL OWNER and retain one for your records.		

OFFICE USE ONLY

T

R

SEC