


1	LOCATION OF WATER WELL:	Fraction	Section	Number	Township	Number	Range	Number
	County: <u>Sedgwick</u>	<u>SW NW NW</u> 1/4 1/4 1/4	<u>6</u>		<u>27S</u>			<u>10</u> E/W

Distance and direction from nearest town or city street address of well if located within city?

2110 W. 24th N.

2	WATER WELL OWNER: <u>Michael Amber</u>
	RR #, St. Address, Box #: City, State, ZIP Code :
	Board of Agriculture, Division of Water Resources Application Number:

3	MARK WELL'S LOCATION WITH AN "X" IN SECTION BOX:	4	DEPTH OF WELL <u>22</u> ft. WELL'S STATIC WATER LEVEL <u>16</u> ft. WELL WAS USED AS: <div style="display: flex; justify-content: space-between;"> <div> 1 Domestic 2 Irrigation 3 Feedlot 4 Industrial </div> <div> 5 Public Water Supply 6 Oil Field Water Supply 7 Domestic (Lawn & Garden) 8 Air Conditioning </div> <div> 9 Dewatering 10 Monitoring Well 11 Injection Well 12 Other </div> </div>
---	--	---	--

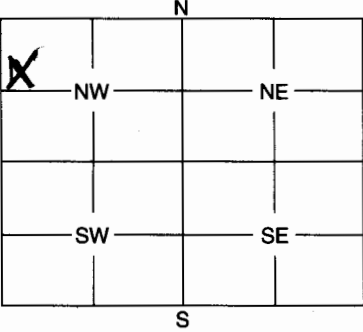

Was a chemical / bacteriological sample submitted to Department? Yes No X.....

If yes, mo/day/yr sample was submitted

Water Well Disinfected: Yes X No

5	TYPE OF BLANK CASING USED:
	<div style="display: flex; flex-wrap: wrap;"> <div>1 Steel</div> <div>3 RMP (SR)</div> <div>5 Wrought</div> <div>7 Fiberglass</div> <div>9 Other (Specify below)</div> <div>2 PVC</div> <div>4 ABS</div> <div>6 Asbestos-Cement</div> <div>8 Concrete Tile</div> </div>
	Blank casing diameter <u>2</u> in. Was casing pulled? Yes No If yes, how much
	Casing height above or below land surface in.

6	GROUT PLUG MATERIAL: 1 Neat cement 2 Cement grout <u>3</u> Bentonite 4 Other Grout Plug Intervals: From ft. to ft., From ft. to ft., From to ft. What is the nearest source of possible contamination: <div style="display: flex; flex-wrap: wrap;"> <div>1 Septic tank</div> <div>6 Seepage pit</div> <div>11 Fuel storage</div> <div>16 Other (specify below)</div> <div>2 Sewer lines</div> <div>7 Pit privy</div> <div>12 Fertilizer storage</div> <div>3 <u>Watertight sewer lines</u></div> <div>8 Sewage lagoon</div> <div>13 Insecticide storage</div> <div>4 Lateral lines</div> <div>9 Feedyard</div> <div>14 Abandoned water well</div> <div>5 Cess pool</div> <div>10 Livestock pens</div> <div>15 Oil well/Gas well</div> </div>
	Direction from well? <u>EAST</u> How many feet? <u>30</u>

FROM	TO	PLUGGING MATERIALS
<u>22</u>	<u>3</u>	<u>Benninte</u>
<u>3</u>	<u>0</u>	<u>Cement</u>

7	CONTRACTOR'S OF LANDOWNER'S CERTIFICATION: This water well was plugged under my jurisdiction and was completed on (mo/day/year) <u>4/16/08</u> and this record is true to the best of my knowledge and belief. Kansas Water Well Contractor's License No. <u>740</u> This Water Well Record was completed on (mo/day/year) <u>4/16/08</u> under the business name of <u>Weninger Plumbing Inc.</u> by (signature) <u>[Signature]</u>
---	--

INSTRUCTIONS: Use typewriter or ball point pen. Please press firmly and print clearly. Please fill in blanks, underline or circle the correct answers. Send top three copies to Kansas Department of Health and Environment, Bureau of Water, Geology Section, 1000 SW Jackson St., Ste. 420, Topeka, Kansas 66612-1367. Telephone: 785/296-5522. Send one to Water Well Owner and retain one for your records.