

WATER WELL PLUGGING RECORD Form WWC-5P
KSA 82a-1212
ID NO.

1 LOCATION OF WATER WELL: County: <u>Sedgwick</u>	Fraction <u>SW 1/4 SE SW 1/4 SE 1/4</u>	Section Number <u>7</u>	Township Number <u>27</u>	Range Number <u>1 EAST E/W</u>
-------------------------------------------------------------	-----------------------------------------	-------------------------	---------------------------	--------------------------------

Distance and direction from nearest town or city street address of well if located within city?

1800 McKee, Wichita
Located in basement w/ concrete floor.
2 WATER WELL OWNER:

RR#, St. Address, Box #:

Coney Ames
1800 McKee

City, State ZIP Code:

Wichita KS 67203
Global Positioning Systems (decimal degrees, min. of 4 digits)

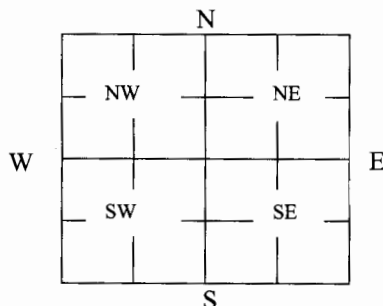
Latitude:

Longitude:

Elevation:

Datum:

Data Collection Method:

3 MARK WELL'S LOCATION WITH AN "X" IN SECTION BOX:

4 DEPTH OF WELL 26 ft.

 WELL'S STATIC WATER LEVEL 15 ft

WELL WAS USED AS:

1 Domestic

2 Irrigation

3 Feedlot

4 Industrial

5 Public Water Supply

6 Oil Field Water Supply

7 Domestic (Lawn & Garden)

8 Air Conditioning

9 Dewatering

10 Monitoring

11 Injection Well

12 Other

 Was a chemical/bacteriological sample submitted to Department? Yes No X
5 TYPE OF BLANK CASING USED:

1 Steel

3 RMP (SR)

5 Wrought

7 Fiberglass

9 Other (Specify below)

2 PVC

4 ABS

6 Asbestos-Cement

8 Concrete Tile

 Blank casing diameter 2 in. Was casing pulled? Yes No X If yes, how much

 Casing height above or below land surface 0 in.

6 GROUT PLUG MATERIAL:

1 Neat cement

2 Cement grout

3 Bentonite

4 Other

 Grout Plug Intervals: From 0 ft. to 26 ft., From ft. to ft., From to ft.

What is the nearest source of possible contamination:

1 Septic tank

6 Seepage pit

11 Fuel Storage

16 Other (specify below)

2 Sewer lines

7 Pit privy

12 Fertilizer storage

3 Watertight sewer lines

8 Sewage lagoon

13 Insecticide storage

4 Lateral lines

9 Feedyard

14 Abandoned water well

 Direction from well? N

5 Cess pool

10 Livestock pens

15 Oil well/Gas well

 How many feet? 7'

FROM	TO	PLUGGING MATERIALS	FROM	TO	PLUGGING MATERIALS

7 CONTRACTOR'S OR LANDOWNER'S CERTIFICATION: This water well was plugged under my jurisdiction and was completed on (mo/day/year) 7/5/08 and this record is true to the best of my knowledge and belief. Kansas Water Well Contractor's License No. . This Water Well Record was completed on (mo/day/year) 7/12/08 under the business name of Coney Ames by (signature) Coney Ames

INSTRUCTIONS: Use typewriter or ballpoint pen. Please press firmly and print clearly. Please fill in blanks, underline or circle the correct answers. Send top three copies to Kansas Department of Health and Environment, Bureau of Water, Geology Section, 1000 SW Jackson St., Ste. 420, Topeka, Kansas 66612-1367. Telephone: 785/296-5522. Send one to Water Well Owner and retain one for your records. Visit us at <http://www.kdheks.gov/geo/waterwells>.