


1	LOCATION OF WATER WELL:	Fraction	Section Number	Township Number	Range Number
County:	Sedgwick	SW $\frac{1}{4}$ SW $\frac{1}{4}$ NW $\frac{1}{4}$	22	27	1E E/W

Distance and direction from nearest town or city street address of well if located within city?  
1900 East Douglas, Wichita, Kansas.

2	WATER WELL OWNER: Bulger Cadillac-Oldsmobile Joe Bulger RR #, St. Address, Box #: 109 Brendonwood Court City, State, ZIP Code : Wichita, KS 67206	Board of Agriculture, Division of Water Resources Application Number:
---	--	--

3 MARK WELL'S LOCATION WITH AN "X" IN SECTION BOX:

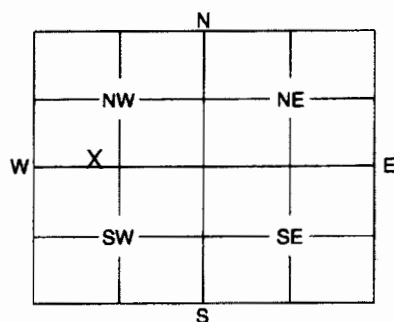

4 DEPTH OF WELL ..... 19.60 ..... ft.

WELL'S STATIC WATER LEVEL ..... 14.95 ..... ft.

WELL WAS USED AS:

- |              |                            |                    |
|--------------|----------------------------|--------------------|
| 1 Domestic   | 5 Public Water Supply      | 9 Dewatering       |
| 2 Irrigation | 6 Oil Field Water Supply   | 10 Monitoring Well |
| 3 Feedlot    | 7 Domestic (Lawn & Garden) | 11 Injection Well  |
| 4 Industrial | 8 Air Conditioning         | 12 Other .....     |

Was a chemical / bacteriological sample submitted to Department? Yes ..... No ..... ☒

If yes, mo/day/yr sample was submitted .....

Water Well Disinfected: Yes ..... No ..... ☒

5 TYPE OF BLANK CASING USED:

- |         |            |                   |                 |                         |
|---------|------------|-------------------|-----------------|-------------------------|
| 1 Steel | 3 RMP (SR) | 5 Wrought         | 7 Fiberglass    | 9 Other (Specify below) |
| 2 PVC   | 4 ABS      | 6 Asbestos-Cement | 8 Concrete Tile |                         |

Blank casing diameter ..... 2 ..... in. Was casing pulled? Yes ..... ☒ No ..... If yes, how much ..... 3 ft. ....

Casing height above or below land surface ..... 3 ft. below ..... in.

6 GROUT PLUG MATERIAL: 1 Neat cement 2 Cement grout 3 Bentonite 4 Other .....

Grout Plug Intervals: From ..... 19.60 ..... ft. to ..... 3 ..... ft., From ..... ft. to ..... ft., From ..... to ..... ft.

What is the nearest source of possible contamination:

- |                          |                   |                         |                          |
|--------------------------|-------------------|-------------------------|--------------------------|
| 1 Septic tank            | 6 Seepage pit     | 11 Fuel storage         | 16 Other (specify below) |
| 2 Sewer lines            | 7 Pit privy       | 12 Fertilizer storage   |                          |
| 3 Watertight sewer lines | 8 Sewage lagoon   | 13 Insecticide storage  |                          |
| 4 Lateral lines          | 9 Feedyard        | 14 Abandoned water well |                          |
| 5 Cess pool              | 10 Livestock pens | 15 Oil well/Gas well    |                          |

Direction from well? ..... How many feet? .....

FROM	TO	PLUGGING MATERIALS
19.60	3	Bentonite
3	0.75	Native Soil
0.75	0	Concrete

7 CONTRACTOR'S OF LANDOWNER'S CERTIFICATION: This water well was plugged under my jurisdiction and was completed on (mo/day/year) ..... August 9, 2008 ..... and this record is true to the best of my knowledge and belief. Kansas Water Well Contractor's License No. .... P.G. #622 ..... This Water Well Record was completed on (mo/day/year) ..... August 25, 2008 ..... under the business name of GeoStat Environmental, LLC. ....  
by (signature) *[Signature]*

INSTRUCTIONS: Use typewriter or ball point pen. Please press firmly and print clearly. Please fill in blanks, underline or circle the correct answers. Send top three copies to Kansas Department of Health and Environment, Bureau of Water, Geology Section, 1000 SW Jackson St., Ste. 420, Topeka, Kansas 66612-1367. Telephone: 785/296-5522. Send one to Water Well Owner and retain one for your records.