

1	LOCATION OF WATER WELL:	Fraction	Section Number	Township Number	Range Number
County: Sedgwick		SE $\frac{1}{4}$ NE $\frac{1}{4}$ NW $\frac{1}{4}$	20	27S	1


Distance and direction from nearest town or city street address of well if located within city?

777 West Central Avenue, Wichita, Kansas

2 WATER WELL OWNER: Westar Energy

RR #, St. Address, Box #: 122 SW 2nd Street
City, State, ZIP Code : Topeka, KS 66603Board of Agriculture, Division of Water Resources
Application Number:

3 MARK WELL'S LOCATION WITH AN "X" IN SECTION BOX:

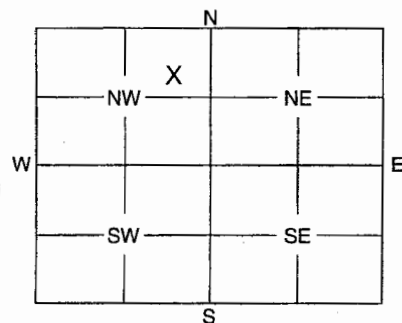

4 DEPTH OF WELL 20.5 ft.

WELL'S STATIC WATER LEVEL 12.65 ft.

WELL WAS USED AS:

- 1 Domestic
- 2 Irrigation
- 3 Feedlot
- 4 Industrial

- 5 Public Water Supply
- 6 Oil Field Water Supply
- 7 Domestic (Lawn & Garden)
- 8 Air Conditioning

- 9 Dewatering
- 10 Monitoring Well
- 11 Injection Well
- 12 Other

Was a chemical / bacteriological sample submitted to Department? Yes No X
If yes, mo/day/yr sample was submitted

Water Well Disinfected: Yes No X

5 TYPE OF BLANK CASING USED:

- 1 Steel
- 2 PVC
- 3 RMP (SR)
- 4 ABS
- 5 Wrought
- 6 Asbestos-Cement
- 7 Fiberglass
- 8 Concrete Tile
- 9 Other (Specify below)

Blank casing diameter in. Was casing pulled? Yes No If yes, how much ~ 3 feet cut off below grade
Casing height above or below land surface in.6 GROUT PLUG MATERIAL: 1 Neat cement 2 Cement grout 3 Bentonite 4 Other Topsoil/grass
Grout Plug Intervals: From 20.5 ft. to 3 ft. From 3 ft. to 0 ft. From to ft.

What is the nearest source of possible contamination:

- 1 Septic tank
- 2 Sewer lines
- 3 Watertight sewer lines
- 4 Lateral lines
- 5 Cess pool
- 6 Seepage pit
- 7 Pit privy
- 8 Sewage lagoon
- 9 Feedyard
- 10 Livestock pens
- 11 Fuel storage
- 12 Fertilizer storage
- 13 Insecticide storage
- 14 Abandoned water well
- 15 Oil well/Gas well
- 16 Other (specify below) Former ASTs

Direction from well? How many feet?

FROM	TO	PLUGGING MATERIALS
20.5	3	Bentonite
3	0	Topsoil/grass

7 CONTRACTOR'S OF LANDOWNER'S CERTIFICATION: This water well was plugged under my jurisdiction and was completed on (mo/day/year) 9/30/2008 and this record is true to the best of my knowledge and belief. Kansas Water Well Contractor's License No. 708 This Water Well Record was completed on (mo/day/year) 10/2/2008 under the business name of Aquaterra Environmental Solutions, Inc. by (signature) *Clash A. Mize*

INSTRUCTIONS: Use typewriter or ball point pen. Please press firmly and print clearly. Please fill in blanks, underline or circle the correct answers. Send top three copies to Kansas Department of Health and Environment, Bureau of Water, Geology Section, 1000 SW Jackson St., Ste. 420, Topeka, Kansas 66612-1367. Telephone: 785/296-5522. Send one to Water Well Owner and retain one for your records.