

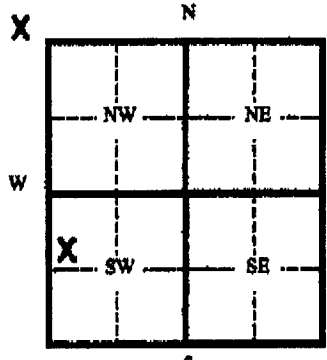
## WATER WELL PLUGGING RECORD

Form WWC-5P

KSA 82a-1212

ID No.

IAS-6

1 LOCATION OF WATER WELL:		Fraction	Section Number	Township Number	Range Number																				
County: Sedgwick		SW 1/4 NW 1/4 SW 1/4	33	27S	1E																				
Distance and direction from nearest town or city street address of well if located within city? 2160 South Broadway, Wichita																									
2 WATER WELL OWNER: Discount Cigarettes RR#, St. Address, Box # 2160 South Broadway City, State, ZIP Code : Wichita, Kansas			Board of Agriculture, Division of Water Resources Application Number:																						
3 MARK WELL'S LOCATION WITH AN "X" IN SECTION BOX:		4 DEPTH OF WELL 29.00 ft.																							
		WELL'S STATIC WATER LEVEL 18.08 ft.																							
		WELL WAS USED AS:																							
		<table border="0"><tr><td>1 Domestic</td><td>5 Public Water Supply</td><td>9 Dewatering</td></tr><tr><td>2 Irrigation</td><td>8 Oil Field Water Supply</td><td>10 Monitoring Well</td></tr><tr><td>3 Feedlot</td><td>7 Lawn and Garden (domestic)</td><td>11 Injection Well</td></tr><tr><td>4 Industrial</td><td>6 Air Conditioning</td><td>12 Other</td></tr></table>				1 Domestic	5 Public Water Supply	9 Dewatering	2 Irrigation	8 Oil Field Water Supply	10 Monitoring Well	3 Feedlot	7 Lawn and Garden (domestic)	11 Injection Well	4 Industrial	6 Air Conditioning	12 Other								
1 Domestic	5 Public Water Supply	9 Dewatering																							
2 Irrigation	8 Oil Field Water Supply	10 Monitoring Well																							
3 Feedlot	7 Lawn and Garden (domestic)	11 Injection Well																							
4 Industrial	6 Air Conditioning	12 Other																							
		Was a chemical/bacteriological sample submitted to Department? Yes No																							
		If yes, mo/day/yr sample was submitted																							
		Water Well Disinfected: Yes No																							
5 TYPE OF BLANK CASING USED:																									
<table border="0"><tr><td>1 Steel</td><td>3 RMP (SR)</td><td>5 Wrought</td><td>7 Fiberglass</td><td>9 Other (specify below)</td></tr><tr><td>2 PVC</td><td>4 ABC</td><td>6 Asbestos-Cement</td><td>8 Concrete Tile</td><td></td></tr></table>						1 Steel	3 RMP (SR)	5 Wrought	7 Fiberglass	9 Other (specify below)	2 PVC	4 ABC	6 Asbestos-Cement	8 Concrete Tile											
1 Steel	3 RMP (SR)	5 Wrought	7 Fiberglass	9 Other (specify below)																					
2 PVC	4 ABC	6 Asbestos-Cement	8 Concrete Tile																						
Blank casing diameter in. Was casing pulled? Yes x No If yes, how much 3 ft																									
Casing height above or below land surface -36 in.																									
6 GROUT PLUG MATERIAL: 1 Neat cement 2 Cement grout 3 Bentonite 4 Other																									
Grout Plug Intervals From 0 ft. to 29 ft. From ft. to ft. From ft. to ft.																									
What is the nearest source of possible contamination:																									
<table border="0"><tr><td>1 Septic tank</td><td>6 Seepage pit</td><td>11 Fuel storage</td><td>16 Other (specify below)</td></tr><tr><td>2 Sewer lines</td><td>7 Pit privy</td><td>12 Fertilizer storage</td><td></td></tr><tr><td>3 Watertight sewer lines</td><td>8 Sewage lagoon</td><td>13 Insecticide storage</td><td></td></tr><tr><td>4 Lateral lines</td><td>9 Feedyard</td><td>14 Abandoned water well</td><td></td></tr><tr><td>5 Cess Pool</td><td>10 Livestock pens</td><td>15 Oil well/ Gas well</td><td></td></tr></table>						1 Septic tank	6 Seepage pit	11 Fuel storage	16 Other (specify below)	2 Sewer lines	7 Pit privy	12 Fertilizer storage		3 Watertight sewer lines	8 Sewage lagoon	13 Insecticide storage		4 Lateral lines	9 Feedyard	14 Abandoned water well		5 Cess Pool	10 Livestock pens	15 Oil well/ Gas well	
1 Septic tank	6 Seepage pit	11 Fuel storage	16 Other (specify below)																						
2 Sewer lines	7 Pit privy	12 Fertilizer storage																							
3 Watertight sewer lines	8 Sewage lagoon	13 Insecticide storage																							
4 Lateral lines	9 Feedyard	14 Abandoned water well																							
5 Cess Pool	10 Livestock pens	15 Oil well/ Gas well																							
Direction from well? How many feet?																									
FROM	TO	CODE	PLUGGING MATERIALS																						
0	29.		Bentonite																						
7 CONTRACTOR'S OR LANDOWNER'S CERTIFICATION: This water well was plugged under my jurisdiction and was completed on (mo/day/yr) 4/30/07 and this record is true to the best of my knowledge and belief. Kansas Water Well Contractor's License No. 554 This Water Well Record was completed on (mo/day/yr) 5/10/07 under the business name of Jay Woofen by MH Woofer Pump and Well by (signature) Jay L. Woofen																									
INSTRUCTIONS: Please fill in blanks and circle the correct answers. Send three copies to Kansas Department of Health and Environment, Bureau of Water, 1000 S W Jackson St., Ste. 420, Topeka, Kansas 66620-0001. Telephone: 785-298-3565. Send one to Water Well Owner and retain one for your records.																									