CORRECTION(S) TO WATER WELL RECORD (WWC-5)
(to rectify lacking or incorrect information)

County: Sedgwick

Location listed as:	**Location changed to:**
Section-Township-Range: 27	34-27S-1E
Fraction (¼ ¼ ¼): None Given	NW SE NE

Other changes: Initial statements: Well owner's name illegible.

Changed to: Scott Shelton

Comments:

verification method: Wellsite address, Sedgwick County appraiser's online parcel search, and mapping tool on KGS website.

initials: DRL date: 9/21/2009

submitted by: Kansas Geological Survey, Data Resources Library, 1930 Constant Ave., Lawrence, KS 66047-3726
to: Kansas Dept of Health & Environment, Bureau of Water, 1000 SW Jackson, Suite 420, Topeka, KS 66612-1367.

WATER WELL PLUGGING RECORD Form WWC-5P KSA 82a-1212 ID NO.

1 LOCATION OF WATER WELL: County: SG	Fraction ¼ ¼ ¼	Section Number	Township Number 27	Range Number 1 (E)/W

Distance and direction from nearest town or city street address of well if located within city?

same as below

2 WATER WELL OWNER:

RR#, St. Address, Box #: 1826 S Erie

City, State ZIP Code: Wichita Ks 67218

Global Positioning Systems (decimal degrees, min. of 4 digits
Latitude: _____
Longitude: _____
Elevation: _____
Datum: _____
Data Collection Method:

3 MARK WELL'S LOCATION WITH AN "X" IN SECTION BOX:

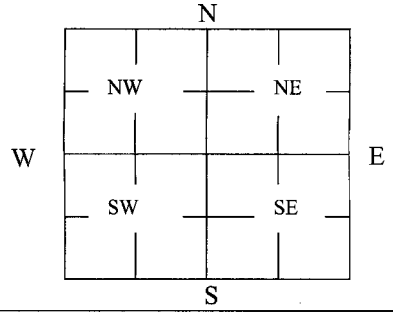

4 DEPTH OF WELL 3 ft.

WELL'S STATIC WATER LEVEL N/A ft

WELL WAS USED AS:

1 Domestic 5 Public Water Supply 9 Dewatering
2 Irrigation 6 Oil Field Water Supply 10 Monitoring
3 Feedlot (7) Domestic (Lawn & Garden) 11 Injection Well
4 Industrial 8 Air Conditioning 12 Other _____

Was a chemical/bacteriological sample submitted to Department? Yes ____ No ✓

5 TYPE OF BLANK CASING USED:

(1) Steel 3 RMP (SR) 5 Wrought 7 Fiberglass 9 Other (Specify below)
2 PVC 4 ABS 6 Asbestos-Cement 8 Concrete Tile _____

Blank casing diameter _____ in. Was casing pulled? Yes _____ No _____ If yes, how much _____
Casing height above or below land surface _____ in.

6 GROUT PLUG MATERIAL: 1 Neat cement (2) Cement grout 3 Bentonite 4 Other _____

Grout Plug Intervals: From 0 ft. to 1 Sand ft., From 1 ft. to 3 ft., From _____ to _____ ft.

What is the nearest source of possible contamination:

1 Septic tank 6 Seepage pit 11 Fuel Storage 16 Other (specify below)
2 Sewer lines 7 Pit privy 12 Fertilizer storage _____
3 Watertight sewer lines 8 Sewage lagoon 13 Insecticide storage
4 Lateral lines 9 Feedyard (14) Abandoned water well Direction from well? _____
5 Cess pool 10 Livestock pens 15 Oil well/Gas well How many feet? _____

FROM	TO	PLUGGING MATERIALS	FROM	TO	PLUGGING MATERIALS
0	1	Sand			
1	3	cement			

7 CONTRACTOR'S OR LANDOWNER'S CERTIFICATION: This water well was plugged under my jurisdiction and was completed on (mo/day/year) 5/18/09 and this record is true to the best of my knowledge and belief. Kansas Water Well Contractor's License No. NA. This Water Well Record was completed on (mo/day/year) 5/18/09 under the business name of Scott Shultz by (signature) _____.

INSTRUCTIONS: Use typewriter or ballpoint pen. Please press firmly and print clearly. Please fill in blanks, underline or circle the correct answers. Send top three copies to Kansas Department of Health and Environment, Bureau of Water, Geology Section, 1000 SW Jackson St., Ste. 420, Topeka, Kansas 66612-1367. Telephone: 785/296-5522. Send one to Water Well Owner and retain one for your records. Visit us at http://www.kdheks.gov/geo/waterwells.