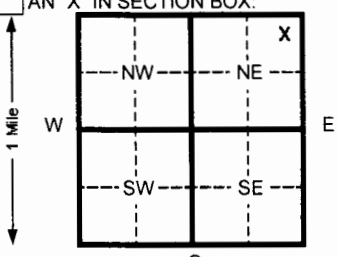


WATER WELL RECORD Form WWC-5 KSA 82a-1212 ID No.

1 LOCATION OF WATER WELL: Fraction		Section Number		Township Number		Range Number	
County: Sedgwick		NE ¼ NE ¼ NE ¼		8		T 27 S R 1 E	
Distance and direction from nearest town or city street address of well if located within city? 21st and Broadway, Wichita							
2 WATER WELL OWNER: City of Wichita							
RR#, St. Address, Box # : 455 N. Main St., MS 1-13				Board of Agriculture, Division of Water Resources			
City, State, ZIP Code : Wichita, KS 67202				Application Number:			
3 LOCATE WELL'S LOCATION WITH AN "X" IN SECTION BOX:		4 DEPTH OF COMPLETED WELL 24 ft. ELEVATION:					
		Depth(s) Groundwater Encountered 1 15 ft. 2 _____ ft. 3 _____ ft.					
		WELL'S STATIC WATER LEVEL _____ ft. below land surface measured on mo/day/yr					
		Pump test data: Well water was _____ ft. after _____ hours pumping _____ gpm					
		Est. Yield _____ gpm: Well water was _____ ft. after _____ hours pumping _____ gpm					
		Bore Hole Diameter 8 in. to 24 ft. and _____ in. to _____ ft.					
		WELL WATER TO BE USED AS: 5 Public water supply 8 Air conditioning 11 Injection well					
		1 Domestic 3 Feed lot 6 Oil field water supply 9 Dewatering 12 Other (Specify below)					
		Air Sparge					
		2 Irrigation 4 Industrial 7 Lawn and garden (domestic) 10 Monitoring well					
		Was a chemical/bacteriological sample submitted to Department? Yes _____ No X If yes, mo/day/yr sample was submitted					
		Water Well Disinfected? Yes _____ No X					
5 TYPE OF BLANK CASING USED:							
1 Steel 3 RMP (SR) 5 Wrought Iron 8 Concrete tile CASING JOINTS: Glued _____ Clamped _____							
2 PVC 4 ABS 6 Asbestos-Cement 9 Other (specify below) Welded _____							
7 Fiberglass _____ Threaded _____ Flush _____							
Blank casing diameter 2 in. to 22 ft., Dia _____ in. to _____ ft., Dia _____ in. to _____ ft.							
Casing height above land surface 0 in., weight 0.703 lbs./ft. Wall thickness or gauge No. SCH. 40							
TYPE OF SCREEN OR PERFORATION MATERIAL:							
1 Steel 3 Stainless steel 5 Fiberglass 8 RMP (SR) 11 Other (specify) _____							
2 Brass 4 Galvanized steel 6 Concrete tile 9 ABS 12 None used (open hole)							
SCREEN OR PERFORATION OPENINGS ARE:							
1 Continuous slot 3 Mill slot 5 Gauzed wrapped 8 Saw cut 11 None (open hole)							
2 Louvered shutter 4 Key punched 6 Wire wrapped 9 Drilled holes							
7 Torch cut 10 Other (specify) _____							
SCREEN-PERFORATED INTERVALS: From 22 ft. to 24 ft. From _____ ft. to _____ ft.							
From _____ ft. to _____ ft. From _____ ft. to _____ ft.							
GRAVEL PACK INTERVALS: From 20 ft. to 24 ft. From _____ ft. to _____ ft.							
From _____ ft. to _____ ft. From _____ ft. to _____ ft.							
6 GROUT MATERIAL: 1 Neat cement 2 Cement grout 3 Bentonite 4 Other Bentonite Grout							
Grout Intervals From 0.5 ft. to 20 ft. From _____ ft. to _____ ft. From _____ ft. to _____ ft.							
What is the nearest source of possible contamination:							
1 Septic tank 4 Lateral lines 7 Pit privy 10 Livestock pens 14 Abandoned water well							
2 Sewer lines 5 Cess pool 8 Sewage lagoon 11 Fuel storage 15 Oil well/ Gas well							
3 Watertight sewer lines 6 Seepage pit 9 Feedyard 12 Fertilizer storage 16 Other (specify below) _____							
13 Insecticide storage _____							
Direction from well? _____ How many feet? _____							
FROM TO CODE LITHOLOGIC LOG FROM TO PLUGGING INTERVALS							
0.0 7.0 Sand, tan, coarse grained							
7.0 8.0 Silty Sand, brown							
8.0 10.0 Sand, tan, medium grained							
10.0 12.0 Clayey Sand, tan, medium to coarse grained							
12.0 14.5 Sand, tan, fine to medium grained							
14.5 15.0 Clayey Sand, tan							
15.0 18.0 Sand, tan, coarse grained							
18.0 18.5 Silty Clay, brown							
18.5 24.0 Sand, gray, coarse grained							
7 CONTRACTOR'S OR LANDOWNER'S CERTIFICATION: This water well was (1) constructed , (2) reconstructed, or (3) plugged under my jurisdiction and was completed on (mo/day/yr) 01/12/10 and this record is true to the best of my knowledge and belief. Kansas							
Water Well Contractor's License No. 531 This Water Well Record was completed on (mo/day/yr) 01/28/10							
under the business name of Geotechnical Services Inc. by (signature) _____							
INSTRUCTIONS: Please fill in blanks and circle the correct answers. Send three copies to Kansas Department of Health and Environment, Bureau of Water, 1000 S W Jackson St., Ste. 420, Topeka, Kansas 66612-1367. Telephone: 913-296-5545. Send one to WATER WELL OWNER and retain one for your records.							