GSI Job No. 097412 **SVE-4**

WATER WELL RECORD Form WWC-5 KSA 82a-1212 ID No. _____

1 LOCATION OF WATER WELL:	Fraction	Section Number	Township Number	Range Number
County: **Sedgwick**	**NE** ¼ **NE** ¼ **NE** ¼	**8**	T **27** S	R **1** E

Distance and direction from nearest town or city street address of well if located within city?
21st and Broadway, Wichita

2 WATER WELL OWNER: **City of Wichita**
RR#, St. Address, Box # : **455 N. Main St., MS 1-13**
City, State, ZIP Code : **Wichita, KS 67202**
Board of Agriculture, Division of Water Resources
Application Number:

3 LOCATE WELL'S LOCATON WITH AN "X" IN SECTION BOX:

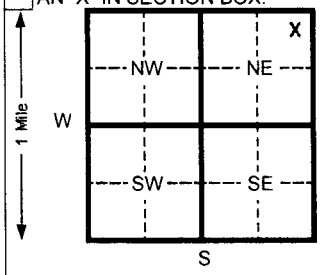

4 DEPTH OF COMPLETED WELL **20** ft. ELEVATION:
Depth(s) Groundwater Encountered 1 **17** ft. 2 ____ ft. 3 ____ ft.
WELL'S STATIC WATER LEVEL ____ ft. below land surface measured on mo/day/yr ____
Pump test data: Well water was ____ ft. after ____ hours pumping ____ gpm
Est. Yield ____ gpm: Well water was ____ ft. after ____ hours pumping ____ gpm
Bore Hole Diameter **10** in. to **20** ft. and ____ in. to ____ ft.
WELL WATER TO BE USED AS: 5 Public water supply 8 Air conditioning 11 Injection well
1 Domestic 3 Feed lot 6 Oil field water supply 9 Dewatering 12 Other (Specify below)
2 Irrigation 4 Industrial 7 Lawn and garden (domestic) 10 Monitoring well **Soil Vapor Extraction**
Was a chemical/bacteriological sample submitted to Department? Yes ____ No **X** If yes, mo/day/yr sample was submitted
Water Well Disinfected? Yes ____ No **X**

5 TYPE OF BLANK CASING USED: 5 Wrought Iron 8 Concrete tile CASING JOINTS: Glued ____ Clamped ____
1 Steel 3 RMP (SR) 6 Asbestos-Cement 9 Other (specify below) Welded
2 PVC 4 ABS 7 Fiberglass ____ Threaded **Flush**
Blank casing diameter **4** in. to **10** ft., Dia ____ in. to ____ ft., Dia ____ in. to ____ ft.
Casing height above land surface **0** in., weight **0.703** lbs./ft. Wall thickness or gauge No. **SCH. 40**
TYPE OF SCREEN OR PERFORATION MATERIAL: 7 PVC 10 Asbestos-cement
1 Steel 3 Stainless steel 5 Fiberglass 8 RMP (SR) 11 Other (specify) ____
2 Brass 4 Galvanized steel 6 Concrete tile 9 ABS 12 None used (open hole)
SCREEN OR PERFORATION OPENINGS ARE: 5 Gauzed wrapped 8 Saw cut 11 None (open hole)
1 Continuous slot 3 Mill slot 6 Wire wrapped 9 Drilled holes
2 Louvered shutter 4 Key punched 7 Torch cut 10 Other (specify) ____
SCREEN-PERFORATED INTERVALS: From **10** ft. to **20** ft. From ____ ft. to ____ ft.
From ____ ft. to ____ ft. From ____ ft. to ____ ft.
GRAVEL PACK INTERVALS: From **8** ft. to **20** ft. From ____ ft. to ____ ft.
From ____ ft. to ____ ft. From ____ ft. to ____ ft.

6 GROUT MATERIAL: 1 Neat cement 2 Cement grout 3 Bentonite 4 Other ____
Grout Intervals From **3** ft. to **8** ft. From ____ ft. to ____ ft. From ____ ft. to ____ ft.
What is the nearest source of possible contamination: 10 Livestock pens 14 Abandoned water well
1 Septic tank 4 Lateral lines 7 Pit privy 11 Fuel storage 15 Oil well/ Gas well
2 Sewer lines 5 Cess pool 8 Sewage lagoon 12 Fertilizer storage 16 Other (specify below)
3 Watertight sewer lines 6 Seepage pit 9 Feedyard 13 Insecticide storage ____
Direction from well? How many feet?

FROM	TO	CODE	LITHOLOGIC LOG	FROM	TO	PLUGGING INTERVALS
0.0	0.5		**Asphalt**			
0.5	8.0	SP	**Fill, Sand, light brown, medium grained, 6-8" thick layer of concrete/brick at 5'**			
8.0	17.0	SP	**Sand, brown, very fine to medium grained**			
17.0	19.0	SM	**Silty Sand, light brown, very fine to fine grained**			
19.0	20.0	SP	**Sand, medium grained**			

7 CONTRACTOR'S OR LANDOWNER'S CERTIFICATION: This water well was (1) constructed, (2) reconstructed, or (3) plugged under my jurisdiction and was completed on (mo/day/yr) **01/13/10** and this record is true to the best of my knowledge and belief. Kansas Water Well Contractor's License No. **531** This Water Well Record was completed on (mo/day/yr) **01/28/10** under the business name of **Geotechnical Services Inc.** by (signature)

INSTRUCTIONS:. Please fill in blanks and circle the correct answers. Send three copies to Kansas Department of Health and Environment, Bureau of Water, 1000 S W Jackson St., Ste. 420, Topeka, Kansas 66612-1367. Telephone: 913-296-5545. Send one to WATER WELL OWNER and retain one for your records.

OFFICE USE ONLY T R SEC

White CopyWhite Copy Form provided by Forms-On-A-Disk, Inc. · Dallas, Texas · (214) 340-9429