

**WATER WELL PLUGGING RECORD Form WWC-5P KSA 82a-1212 ID NO.**

\_\_\_\_\_


**1 LOCATION OF WATER WELL:** County: Sedgwick Fraction NW 1/4 NW 1/4 NW 1/4 SE 1/4 Section Number 21 Township Number T 27 S Range Number 1  E  W

Street/Rural Address of Well Location; if unknown, distance & direction from nearest town or intersection: If at owner's address, check here  1010 East Douglas, Wichita, KS

**Global Positioning Systems (GPS) information:**  
 Latitude: \_\_\_\_\_ (in decimal degrees)  
 Longitude: \_\_\_\_\_ (in decimal degrees)  
 Elevation: \_\_\_\_\_  
 Datum:  WGS84,  NAD83,  NAD27  
 Collection Method:  
 GPS unit (Make/Model: \_\_\_\_\_)  
 Digital Map/Photo,  Topographic Map,  Land Survey  
 Est. Accuracy:  < 3 m,  3-5 m,  5-15 m,  > 15 m

**2 WATER WELL OWNER:** QuikTrip Corporation  
 RR#, St. Address, Box #: 4705 S. 129th East Ave.  
 City, State ZIP Code: Tulsa, OK 74146

**3 MARK WELL'S LOCATION WITH AN "X" IN SECTION BOX:**

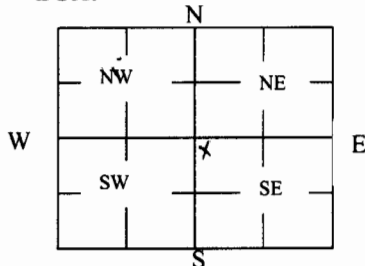

**4 DEPTH OF WELL** 26.93 ft.

WELL'S STATIC WATER LEVE 13.60 ft

WELL WAS USED AS:

- Domestic
- Irrigation
- Feedlot
- Industrial
- Public Water Supply
- Oil Field Water Supply
- Domestic (Lawn & Garden)
- Air Conditioning
- Dewatering
- Monitoring
- Injection Well
- Other AS4

Was a chemical/bacteriological sample submitted to Department? Yes  No

**5 TYPE OF BLANK CASING USED:**

- Steel
- RMP (SR)
- Wrought
- Fiberglass
- Other (Specify below) \_\_\_\_\_
- PVC
- ABS
- Asbestos-Cement
- Concrete Tile

Blank casing diameter 2 in. Was casing pulled? Yes  No  If yes, how much 3 Feet  
 Casing height above or below land surface \_\_\_\_\_ in.

**6 GROUT PLUG MATERIAL:**  Neat cement  Cement grout  Bentonite  Other \_\_\_\_\_

Grout Plug Intervals: From 3 ft. to 26.93 ft., From \_\_\_\_\_ ft. to \_\_\_\_\_ ft., From \_\_\_\_\_ to \_\_\_\_\_ ft.

What is the nearest source of possible contamination:

- Septic tank
  - Sewer lines
  - Watertight sewer lines
  - Lateral lines
  - Cess pool
  - Seepage pit
  - Pit privy
  - Sewage lagoon
  - Feedyard
  - Livestock pens
  - Fuel Storage
  - Fertilizer storage
  - Insecticide storage
  - Abandoned water well
  - Oil well/Gas well
  - Other (specify below) Lust Site
- Direction from well? \_\_\_\_\_  
 How many feet? \_\_\_\_\_

FROM	TO	PLUGGING MATERIALS	FROM	TO	PLUGGING MATERIALS
0	1	Concrete			
1	3	Native Soils			
3	26.93	Bentonite Grout			
					AS4

**Original Returned to Sender for Correction Date: 1-14-10**

**7 CONTRACTOR'S OR LANDOWNER'S CERTIFICATION:** This water well was plugged under my jurisdiction and was completed on (mo/day/year) 11/30/2009 and this record is true to the best of my knowledge and belief. Kansas Water Well Contractor's License No. 594. This Water Well Record was completed on (mo/day/year) 12/23/2009 under the business name of Coranco Great Plains, Inc. by (signature) \_\_\_\_\_

**INSTRUCTIONS:** Use typewriter or ballpoint pen. Please press firmly and print clearly. Please fill in blanks, underline or circle the correct answers. Send top three copies to Kansas Department of Health and Environment, Bureau of Water, Geology Section, 1000 SW Jackson St., Ste. 420, Topeka, Kansas 66612-1367. Telephone: 785/296-5524. Send one to Water Well Owner and retain one for your records. Visit us at <http://www.kdheks.gov/waterwell/index.html>.

Check one:  White Copy  Blue Copy  Pink Copy