

WATER WELL PLUGGING RECORD Form WWC-5P

KSA 82a-1212 ID NO.

1 LOCATION OF WATER WELL:

County: **SEDGWICK**

Fraction

SE 1/4 SE 1/4 NE 1/4

Section Number

7

Township Number

T27S

Range Number

R1E E/W

Distance and direction from nearest town or city street address of well if located within city?

Basement - 1838 N. GARLAND WICHITA KS 672032 WATER WELL OWNER: **NANCY**

RR#, St. Address, Box #:

**1838 N. Garland
Wichita KS 67203**

City, State ZIP Code:

Global Positioning Systems (decimal degrees, min. of 4 digits)

Latitude: _____

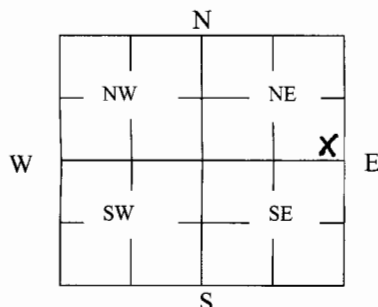
Longitude: _____

Elevation: _____

Datum: _____

Data Collection Method: _____

3 MARK WELL'S LOCATION WITH AN "X" IN SECTION BOX:

4 DEPTH OF WELL **21** ft.WELL'S STATIC WATER LEVEL **12** ft.

WELL WAS USED AS:

- 1 Domestic
2 Irrigation
3 Feedlot
4 Industrial

- 5 Public Water Supply
6 Oil Field Water Supply
7 **Domestic (Lawn & Garden)**
8 Air Conditioning

- 9 Dewatering
10 Monitoring
11 Injection Well
12 Other _____

Was a chemical/bacteriological sample submitted to Department? Yes ☒ No ☒

5 TYPE OF BLANK CASING USED:

- 1 **Steel**
2 PVC

- 3 RMP (SR)
4 ABS

- 5 Wrought
6 Asbestos-Cement

- 7 Fiberglass
8 Concrete Tile

- 9 Other (Specify below) _____

Blank casing diameter **13/4** in. Was casing pulled? Yes ☒ No ☐ If yes, how much **5 ft**
Casing height above or below land surface **5 ft** in.

6 GROUT PLUG MATERIAL:

- 1 Neat cement

- 2 **Cement grout**

- 3 **Bentonite**

- 4 Other _____

Grout Plug Intervals: From **21** ft. to **1** ft., From **1** ft. to **0** ft., From _____ to _____ ft.

What is the nearest source of possible contamination:

- 1 Septic tank

- 6 Seepage pit

- 11 Fuel Storage

- 16 Other (specify below) _____

- 2 **Sewer lines**

- 7 Pit privy

- 12 Fertilizer storage

- 3 Watertight sewer lines

- 8 Sewage lagoon

- 13 Insecticide storage

- 4 Lateral lines

- 9 Feedyard

- 14 Abandoned water well

Direction from well? _____

- 5 Cess pool

- 10 Livestock pens

- 15 Oil well/Gas well

How many feet? **3 feet**

FROM	TO	PLUGGING MATERIALS	FROM	TO	PLUGGING MATERIALS
1	0	Cement			
21	1	Bentonite/bleach			

7 CONTRACTOR'S OR LANDOWNER'S CERTIFICATION: This water well was plugged under my jurisdiction and was completed on (mo/day/year) **3/6/10** and this record is true to the best of my knowledge and belief. Kansas Water Well Contractor's License No. **628**. This Water Well Record was completed on (mo/day/year) **3/6/10** under the business name of **JME Enterprises** by (signature) *[Signature]*

INSTRUCTIONS: Use typewriter or ballpoint pen. Please press firmly and print clearly. Please fill in blanks, underline or circle the correct answers. Send top three copies to Kansas Department of Health and Environment, Bureau of Water, Geology Section, 1000 SW Jackson St., Ste. 420, Topeka, Kansas 66612-1367. Telephone: 785/296-5522. Send one to Water Well Owner and retain one for your records. Visit us at <http://www.kdheks.gov/geo/waterwells>.