

WATER WELL PLUGGING RECORD Form WWC-5P

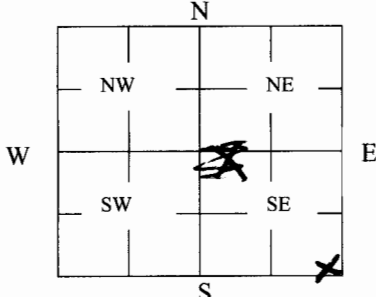
KSA 82a-1212

ID NO.

1 LOCATION OF WATER WELL: County: <u>Sedgwick</u>	Fraction <u>SE 1/4 SE 1/4 SE 1/4</u>	Section Number <u>33</u>	Township Number <u>27</u>	Range Number <u>1</u>
--	---	-----------------------------	------------------------------	--------------------------

Distance and direction from nearest town or city street address of well if located within city?

2 WATER WELL OWNER: <u>Toni Losh</u> RR#, St. Address, Box #: <u>2302 S. Greenwood</u> City, State ZIP Code: <u>Wichita, KS 67211</u>	Global Positioning Systems (decimal degrees, min. of 4 digits) Latitude: _____ Longitude: _____ Elevation: _____ Datum: _____ Data Collection Method: _____
---	--

3 MARK WELL'S LOCATION WITH AN "X" IN SECTION BOX: 	4 DEPTH OF WELL <u>26</u> ft. WELL'S STATIC WATER LEVEL <u>17</u> ft. WELL WAS USED AS: 1 Domestic <u>2 Irrigation</u> 3 Feedlot 4 Industrial 5 Public Water Supply 6 Oil Field Water Supply 7 Domestic (Lawn & Garden) 8 Air Conditioning 9 Dewatering 10 Monitoring 11 Injection Well 12 Other _____ Was a chemical/bacteriological sample submitted to Department? Yes _____ No <input checked="" type="checkbox"/>
--	---

5 TYPE OF BLANK CASING USED: 1 Steel <u>2 PVC</u> 3 RMP (SR) 4 ABS 5 Wrought 6 Asbestos-Cement 7 Fiberglass 8 Concrete Tile 9 Other (Specify below) _____	Blank casing diameter <u>5</u> in. Was casing pulled? Yes _____ No <input checked="" type="checkbox"/> Casing height above or below land surface <u>36</u> in. If yes, how much _____
--	--

6 GROUT PLUG MATERIAL: <u>1 Neat cement</u> 2 Cement grout 3 Bentonite 4 Other _____	Grout Plug Intervals: From <u>26</u> ft. to <u>3</u> ft., From _____ ft. to _____ ft., From _____ to _____ ft.
What is the nearest source of possible contamination: 1 <u>Septic tank</u> <u>2 Sewer lines</u> 3 Watertight sewer lines 4 Lateral lines 5 Cess pool 6 Seepage pit 7 Pit privy 8 Sewage lagoon 9 Feedyard 10 Livestock pens 11 Fuel Storage 12 Fertilizer storage 13 Insecticide storage 14 Abandoned water well 15 Oil well/Gas well 16 Other (specify below) _____	Direction from well? <u>South</u> How many feet? <u>18</u>

FROM	TO	PLUGGING MATERIALS	FROM	TO	PLUGGING MATERIALS
<u>26</u>	<u>3</u>	<u>Neat Cement</u>			
<u>3</u>	<u>0</u>	<u>compacted soil</u>			

7 CONTRACTOR'S OR LANDOWNER'S CERTIFICATION: This water well was plugged under my jurisdiction and was completed on (mo/day/year) 4/27/2010 and this record is true to the best of my knowledge and belief. Kansas Water Well Contractor's License No. NA. This Water Well Record was completed on (mo/day/year) 4/30/2010 under the business name of A Good Plumber, Inc. by (signature) Karen S. Dwyer, President

INSTRUCTIONS: Use typewriter or ballpoint pen. Please press firmly and print clearly. Please fill in blanks, underline or circle the correct answers. Send top three copies to Kansas Department of Health and Environment, Bureau of Water, Geology Section, 1000 SW Jackson St., Ste. 420, Topeka, Kansas 66612-1367. Telephone: 785/296-5522. Send one to Water Well Owner and retain one for your records. Visit us at <http://www.kdheks.gov/geo/waterwells>.