

1 LOCATION OF WATER WELL:	Fraction	Section Number	Township Number	Range Number
County: <b>Sedgwick</b>	<b>SW</b> $\frac{1}{4}$ <b>NW</b> $\frac{1}{4}$ <b>SW</b> $\frac{1}{4}$	<b>15</b>	T <b>27</b> S	R <b>1</b> <b>E</b>

Distance and direction from nearest town or city street address of well if located within city?


**North side of Murdock, west of Minneapolis (10' E of PW-02) - Wichita**2 WATER WELL OWNER: **Union Pacific Railroad**RR#, St. Address, Box # : **1416 Dodge St., Rm. 930**

Board of Agriculture, Division of Water Resources

City, State, ZIP Code : **Omaha, NE 68179**

Application Number:

3 LOCATE WELL'S LOCATION WITH AN "X" IN SECTION BOX:

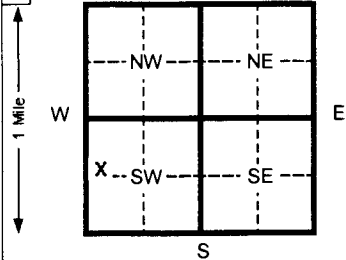

4 DEPTH OF COMPLETED WELL

**24.5** ft. ELEVATION:**1298.33 (TOC)**Depth(s) Groundwater Encountered 1 **15** ft. 2 \_\_\_\_\_ ft. 3 \_\_\_\_\_ ft.WELL'S STATIC WATER LEVEL **14.90** ft. below TOC measured on mo/day/yr

Pump test data: Well water was \_\_\_\_\_ ft. after \_\_\_\_\_ hours pumping \_\_\_\_\_ gpm

Est. Yield \_\_\_\_\_ gpm: Well water was \_\_\_\_\_ ft. after \_\_\_\_\_ hours pumping \_\_\_\_\_ gpm

Bore Hole Diameter **8.25** in. to **25** ft. and \_\_\_\_\_ in. to \_\_\_\_\_ ft.

WELL WATER TO BE USED AS: 5 Public water supply 8 Air conditioning 11 Injection well

1 Domestic 3 Feed lot 6 Oil field water supply 9 Dewatering 12 Other (Specify below)

2 Irrigation 4 Industrial 7 Lawn and garden (domestic) **10 Monitoring well**Was a chemical/bacteriological sample submitted to Department? Yes \_\_\_\_\_ No **X** If yes, mo/day/yr sample was submittedWater Well Disinfected? Yes \_\_\_\_\_ No **X**

5 TYPE OF BLANK CASING USED:

5 Wrought Iron

8 Concrete tile

CASING JOINTS: Glued \_\_\_\_\_ Clamped \_\_\_\_\_

1 Steel

3 RMP (SR)

6 Asbestos-Cement

9 Other (specify below)

Welded

**2 PVC**

4 ABS

7 Fiberglass

Threaded

**Flush**Blank casing diameter **2** in. to **14.5** ft., Dia \_\_\_\_\_ in. to \_\_\_\_\_ ft., Dia \_\_\_\_\_ in. to \_\_\_\_\_ ft.Casing height above land surface **0** in., weight **0.703** lbs./ft. Wall thickness or gauge No. **SCH. 40**

TYPE OF SCREEN OR PERFORATION MATERIAL:

**7 PVC**

10 Asbestos-cement

1 Steel

3 Stainless steel

5 Fiberglass

8 RMP (SR)

11 Other (specify)

2 Brass

4 Galvanized steel

6 Concrete tile

9 ABS

12 None used (open hole)

SCREEN OR PERFORATION OPENINGS ARE:

5 Gauzed wrapped

8 Saw cut

11 None (open hole)

1 Continuous slot

**3 Mill slot**

6 Wire wrapped

9 Drilled holes

2 Louvered shutter

4 Key punched

7 Torch cut

10 Other (specify)

SCREEN-PERFORATED INTERVALS: From **14.5** ft. to **24.5** ft. From \_\_\_\_\_ ft. to \_\_\_\_\_ ft.

From \_\_\_\_\_ ft. to \_\_\_\_\_ ft. From \_\_\_\_\_ ft. to \_\_\_\_\_ ft.

GRAVEL PACK INTERVALS: From **12** ft. to **25** ft. From \_\_\_\_\_ ft. to \_\_\_\_\_ ft.

From \_\_\_\_\_ ft. to \_\_\_\_\_ ft. From \_\_\_\_\_ ft. to \_\_\_\_\_ ft.

6 GROUT MATERIAL:

1 Neat cement

2 Cement grout

**3 Bentonite**

4 Other \_\_\_\_\_

Grout Intervals From **1** ft. to **12** ft. From \_\_\_\_\_ ft. to \_\_\_\_\_ ft. From \_\_\_\_\_ ft. to \_\_\_\_\_ ft.

What is the nearest source of possible contamination:

1 Septic tank

4 Lateral lines

7 Pit privy

10 Livestock pens

14 Abandoned water well

2 Sewer lines

5 Cess pool

8 Sewage lagoon

11 Fuel storage

15 Oil well/ Gas well

3 Watertight sewer lines

6 Seepage pit

9 Feedyard

12 Fertilizer storage

16 Other (specify below)

13 Insecticide storage

Direction from well?

How many feet?

FROM	TO	CODE	LITHOLOGIC LOG	FROM	TO	GPS COORDINATES
<b>0</b>	<b>10</b>		<b>Silt, brown to dark brown, with some fine sand below 7.5'</b>			
<b>10</b>	<b>12.5</b>		<b>Sandy Silt, brown</b>			
<b>12.5</b>	<b>20</b>		<b>Sand, fine to medium grained, poorly graded, brown</b>			
<b>20</b>	<b>22.5</b>		<b>Sand, medium to coarse grained, well graded, with pebbles, brown</b>			
<b>22.5</b>	<b>25</b>		<b>Sand, fine grained, poorly grade, brown, contact with clayey shale at 25'</b>			

7 CONTRACTOR'S OR LANDOWNER'S CERTIFICATION: This water well was **(1) constructed**, (2) reconstructed, or (3) plugged under my jurisdiction and was completed on (mo/day/yr) **07/08/11**

and this record is true to the best of my knowledge and belief. Kansas

Water Well Contractor's License No. **531**This Water Well Record was completed on (mo/day/yr) **07/27/11**

under the business name of

**Geotechnical Services Inc.**by (signature) *[Signature]*

INSTRUCTIONS: Please fill in blanks and circle the correct answers. Send three copies to Kansas Department of Health and Environment, Bureau of Water, 1000 S W Jackson St., Ste. 420, Topeka, Kansas 66612-1367. Telephone: 913-296-5545. Send one to WATER WELL OWNER and retain one for your records.