

## WATER WELL PLUGGING RECORD Form WWC-5P

KSA 82a-1212

ID NO.

1 LOCATION OF WATER WELL: County: Sedgwick Fraction NE 1/4 SW 1/4 E 1/4 Section Number 22 Township Number 27S Range Number 1E

Distance and direction from nearest town or city street address of well if located within city?

334 S Estelle

## 2 WATER WELL OWNER:

RR#, St. Address, Box #: 334 S EstelleCity, State ZIP Code: Wichita, KS.

## Global Positioning Systems (decimal degrees, min. of 4 digits)

Latitude: \_\_\_\_\_

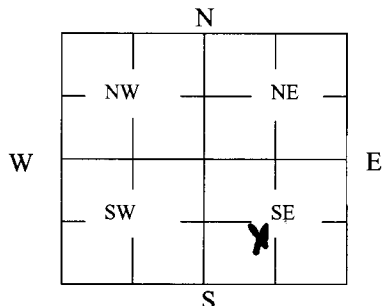
Longitude: \_\_\_\_\_

Elevation: \_\_\_\_\_

Datum: \_\_\_\_\_

Data Collection Method: \_\_\_\_\_

## 3 MARK WELL'S LOCATION WITH AN "X" IN SECTION BOX:

4 DEPTH OF WELL 28 ft.WELL'S STATIC WATER LEVEL 17 ft.

## WELL WAS USED AS:

1 Domestic

2 Irrigation

3 Feedlot

4 Industrial

5 Public Water Supply

6 Oil Field Water Supply

☒ 7 Domestic (Lawn & Garden)

8 Air Conditioning

9 Dewatering

10 Monitoring

11 Injection Well

12 Other \_\_\_\_\_

Was a chemical/bacteriological sample submitted to Department? Yes \_\_\_\_\_ No ☒

## 5 TYPE OF BLANK CASING USED:

☒ 1 Steel

2 PVC

3 RMP (SR)

4 ABS

5 Wrought

6 Asbestos-Cement

7 Fiberglass

8 Concrete Tile

9 Other (Specify below) \_\_\_\_\_

Blank casing diameter 1 1/2 in. Was casing pulled? Yes ☒ No \_\_\_\_\_ If yes, how much 3ft+Casing height above or below land surface 3ft Below

## 6 GROUT PLUG MATERIAL:

1 Neat cement

2 Cement grout

☒ 3 Bentonite

4 Other \_\_\_\_\_

Grout Plug Intervals: From 27 ft. to 3 ft., From \_\_\_\_\_ ft. to \_\_\_\_\_ ft., From \_\_\_\_\_ to \_\_\_\_\_ ft.

What is the nearest source of possible contamination:

1 Septic tank

6 Seepage pit

11 Fuel Storage

16 Other (specify below) \_\_\_\_\_

☒ 2 Sewer lines

7 Pit privy

12 Fertilizer storage

3 Watertight sewer lines

8 Sewage lagoon

13 Insecticide storage

4 Lateral lines

9 Feedyard

14 Abandoned water well

Direction from well? East

5 Cess pool

10 Livestock pens

15 Oil well/Gas well

How many feet? 30ft

| FROM       | TO        | PLUGGING MATERIALS | FROM | TO | PLUGGING MATERIALS |
|------------|-----------|--------------------|------|----|--------------------|
| <u>27'</u> | <u>3'</u> | <u>Bentonite</u>   |      |    |                    |
| <u>3'</u>  | <u>0</u>  | <u>Top Soil</u>    |      |    |                    |
|            |           |                    |      |    |                    |
|            |           |                    |      |    |                    |
7 CONTRACTOR'S OR LANDOWNER'S CERTIFICATION: This water well was plugged under my jurisdiction and was completed on (mo/day/year) 8-31-11 and this record is true to the best of my knowledge and belief. Kansas Water Well Contractor's License No. 740. This Water Well Record was completed on (mo/day/year) 9/22/11 under the business name of Weninger Drilling Inc by (signature) Jon Weninger

INSTRUCTIONS: Use typewriter or ballpoint pen. Please press firmly and print clearly. Please fill in blanks, underline or circle the correct answers. Send top three copies to Kansas Department of Health and Environment, Bureau of Water, Geology Section, 1000 SW Jackson St., Ste. 420, Topeka, Kansas 66612-1367. Telephone: 785/296-5522. Send one to Water Well Owner and retain one for your records. Visit us at <http://www.kdheks.gov/geo/waterwells>.