

**WATER WELL PLUGGING RECORD Form WWC-5P KSA 82a-1212 ID NO.**


1 **LOCATION OF WATER WELL:** Fraction SW NE SE NW Section Number 32 Township Number T 27 S Range Number R 1 E E/W

County: SEDGWICK Distance and direction from nearest town or city street address of well if located within city?

Basement - 626 Funston Wichita KS 67213

2 **WATER WELL OWNER:** NANLY DEMOTT Global Positioning Systems (decimal degrees, min. of 4 digits)  
 RR#, St. Address, Box #: 626 Funston Latitude: \_\_\_\_\_  
 City, State ZIP Code: Wichita KS 67213 Longitude: \_\_\_\_\_  
 Elevation: \_\_\_\_\_  
 Datum: \_\_\_\_\_  
 Data Collection Method: \_\_\_\_\_

3 **MARK WELL'S LOCATION WITH AN "X" IN SECTION BOX:**

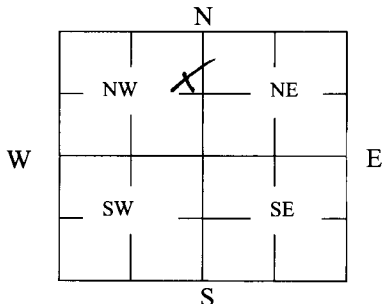

4 **DEPTH OF WELL** 10 ft.

WELL'S STATIC WATER LEVEL \_\_\_\_\_ ft

WELL WAS USED AS:

- |              |                                       |                   |
|--------------|---------------------------------------|-------------------|
| 1 Domestic   | 5 Public Water Supply                 | 9 Dewatering      |
| 2 Irrigation | 6 Oil Field Water Supply              | 10 Monitoring     |
| 3 Feedlot    | <u>7 Domestic (Lawn &amp; Garden)</u> | 11 Injection Well |
| 4 Industrial | 8 Air Conditioning                    | 12 Other _____    |

Was a chemical/bacteriological sample submitted to Department? Yes \_\_\_\_\_ No X

5 **TYPE OF BLANK CASING USED:**

- |                |            |                   |                 |                               |
|----------------|------------|-------------------|-----------------|-------------------------------|
| <u>1 Steel</u> | 3 RMP (SR) | 5 Wrought         | 7 Fiberglass    | 9 Other (Specify below) _____ |
| 2 PVC          | 4 ABS      | 6 Asbestos-Cement | 8 Concrete Tile |                               |

Blank casing diameter 3/4 in. Was casing pulled? Yes X No \_\_\_\_\_ If yes, how much 6'  
 Casing height above or below land surface 6'

6 **GROUT PLUG MATERIAL:** 1 Neat cement 2 Cement grout 3 Bentonite 4 Other \_\_\_\_\_

Grout Plug Intervals: From 10 ft. to 0 ft., From \_\_\_\_\_ ft. to \_\_\_\_\_ ft., From \_\_\_\_\_ to \_\_\_\_\_ ft.

What is the nearest source of possible contamination:

- |                          |                   |                         |  |
|--------------------------|-------------------|-------------------------|--|
| 1 Septic tank            | 6 Seepage pit     | 11 Fuel Storage         | 16 Other (specify below) <u>Well was abandoned</u> |
| 2 Sewer lines            | 7 Pit privy       | 12 Fertilizer storage   |  |
| 3 Watertight sewer lines | 8 Sewage lagoon   | 13 Insecticide storage  |  |
| 4 Lateral lines          | 9 Feedyard        | 14 Abandoned water well | Direction from well? _____                         |
| 5 Cess pool              | 10 Livestock pens | 15 Oil well/Gas well    | How many feet? _____                               |

FROM	TO	PLUGGING MATERIALS	FROM	TO	PLUGGING MATERIALS
<u>10</u>	<u>0</u>	<u>Cement</u>			

7 **CONTRACTOR'S OR LANDOWNER'S CERTIFICATION:** This water well was plugged under my jurisdiction and was completed on (mo/day/year) 6/6/12 and this record is true to the best of my knowledge and belief. Kansas Water Well Contractor's License No. 628. This Water Well Record was completed on (mo/day/year) 6/6/12 under the business name of JME Enterprises by (signature) [Signature]

**INSTRUCTIONS:** Use typewriter or ballpoint pen. Please press firmly and print clearly. Please fill in blanks, underline or circle the correct answers. Send top three copies to Kansas Department of Health and Environment, Bureau of Water, Geology Section, 1000 SW Jackson St., Ste. 420, Topeka, Kansas 66612-1367. Telephone: 785/296-5522. Send one to Water Well Owner and retain one for your records. Visit us at <http://www.kdheks.gov/geo/waterwells>.