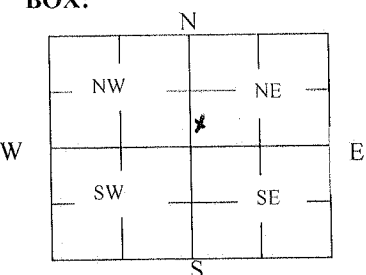


MW-6

WATER WELL PLUGGING RECORD Form WWC-5P KSA 82a-1212 ID NO.

1 LOCATION OF WATER WELL: County: Sedgwick	Fraction NE 1/4 SW 1/4 SW 1/4 NE 1/4	Section Number 28	Township Number T 27 S	Range Number 1 ☒ E ☐ W
Street/Rural Address of Well Location; if unknown, distance & direction from nearest town or intersection: If at owner's address, check here ☒		Global Positioning Systems (GPS) information: Latitude: 37.6770 (in decimal degrees) Longitude: 97.3259 (in decimal degrees) Elevation: Datum: ☐ WGS84, ☒ NAD83, ☐ NAD27 Collection Method: ☒ GPS unit (Make/Model: Garmin etrex 10) ☐ Digital Map/Photo, ☐ Topographic Map, ☐ Land Survey Est. Accuracy: ☐ < 3 m, ☒ 3-5 m, ☐ 5-15 m, ☐ > 15 m		
2 WATER WELL OWNER: Michigan Reutilization LLC RR#, St. Address, Box #: 1023 Lincoln St. City, State ZIP Code: Wichita, KS				

3 MARK WELL'S LOCATION WITH AN "X" IN SECTION BOX: 	4 DEPTH OF WELL 20 ft. WELL'S STATIC WATER LEVEL 17.8 ft WELL WAS USED AS: <table border="0"><tr><td>☐ Domestic</td><td>☐ Public Water Supply</td><td>☐ Dewatering</td></tr><tr><td>☐ Irrigation</td><td>☐ Oil Field Water Supply</td><td>☒ Monitoring</td></tr><tr><td>☐ Feedlot</td><td>☐ Domestic (Lawn & Garden)</td><td>☐ Injection Well</td></tr><tr><td>☐ Industrial</td><td>☐ Air Conditioning</td><td>☐ Other</td></tr></table> Was a chemical/bacteriological sample submitted to Department? Yes ☐ No ☒	☐ Domestic	☐ Public Water Supply	☐ Dewatering	☐ Irrigation	☐ Oil Field Water Supply	☒ Monitoring	☐ Feedlot	☐ Domestic (Lawn & Garden)	☐ Injection Well	☐ Industrial	☐ Air Conditioning	☐ Other

5 TYPE OF BLANK CASING USED:

☒ Steel	☐ RMP (SR)	☐ Wrought	☐ Fiberglass	☐ Other (Specify below)
☒ PVC	☐ ABS	☐ Asbestos-Cement	☐ Concrete Tile	

Blank casing diameter 2 in. Was casing pulled? Yes ☒ No ☐ If yes, how much 5
Casing height above or below land surface 4 in.


6 GROUT PLUG MATERIAL: ☐ Neat cement ☐ Cement grout ☒ Bentonite ☐ Other

Grout Plug Intervals: From 3 ft. to 20 ft., From ft. to ft., From to ft.

What is the nearest source of possible contamination:

☐ Septic tank	☐ Seepage pit	☒ Fuel Storage	☐ Other (specify below)
☐ Sewer lines	☐ Pit privy	☐ Fertilizer storage	
☐ Watertight sewer lines	☐ Sewage lagoon	☐ Insecticide storage	
☐ Lateral lines	☐ Feedyard	☐ Abandoned water well	Direction from well?
☐ Cess pool	☐ Livestock pens	☐ Oil well/Gas well	How many feet?

FROM	TO	PLUGGING MATERIALS	FROM	TO	PLUGGING MATERIALS
0	3	Topsoil			
3	20	Bentonite Grout			

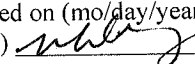7 CONTRACTOR'S OR LANDOWNER'S CERTIFICATION: This water well was plugged under my jurisdiction and was completed on (mo/day/year) 04/23/2013 and this record is true to the best of my knowledge and belief. Kansas Water Well Contractor's License No. 710. This Water Well Record was completed on (mo/day/year) 04/25/2013 under the business name of Below Ground Surface, Inc. by (signature) 

INSTRUCTIONS: Use typewriter or ballpoint pen. Please press firmly and print clearly. Please fill in blanks, underline or circle the correct answers. Send top three copies to Kansas Department of Health and Environment, Bureau of Water, Geology Section, 1000 SW Jackson St., Ste. 420, Topeka, Kansas 66612-1367. Telephone: 785/296-5524. Send one to Water Well Owner and retain one for your records. Visit us at <http://www.kdheks.gov/waterwell/index.html>.

Check one: ☐ White Copy ☐ Blue Copy ☐ Pink Copy