

WATER WELL PLUGGING RECORD Form WWC-5P

KSA 82a-1212

ID NO.

1 LOCATION OF WATER WELL: Fraction NW 1/4 SE 1/4 NW 1/4 1/4 Section Number 29 Township Number T 27 S Range Number 18 E ☐ W

Street/Rural Address of Well Location; if unknown, distance & direction from nearest town or intersection: If at owner's address, check here ☐

524 Dayton Wichita KS 67217

2 WATER WELL OWNER: Terry Konnie Hoffman
RR#, St. Address, Box #: 1951 Anita
City, State ZIP Code: Wichita KS 67213

Global Positioning Systems (GPS) information:

Latitude: _____ (in decimal degrees)

Longitude: _____ (in decimal degrees)

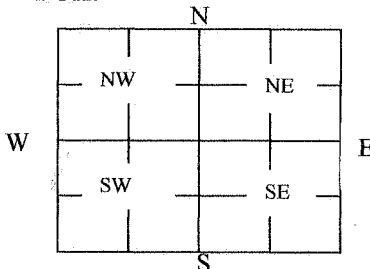
Elevation: _____

Datum: ☐ WGS84, ☐ NAD83, ☐ NAD27

Collection Method: _____

☐ GPS unit (Make/Model): _____☐ Digital Map/Photo, ☐ Topographic Map, ☐ Land SurveyEst. Accuracy: ☐ <3 m, ☐ 3-5 m, ☐ 5-15 m, ☐ >15 m

3 MARK WELL'S LOCATION WITH AN "X" IN SECTION BOX:

4 DEPTH OF WELL 22 ft.WELL'S STATIC WATER LEVEL 19 ft

WELL WAS USED AS:

☐
☐
☐
☐

Domestic
Irrigation
Feedlot
Industrial

☐
☒
☐
☐

Public Water Supply
Oil Field Water Supply
Domestic (Lawn & Garden)
Air Conditioning

☐
☐
☐
☐

Dewatering
Monitoring
Injection Well
Other _____

Was a chemical/bacteriological sample submitted to Department? Yes ☐ No ☒

5 TYPE OF BLANK CASING USED:

☒
☐

Steel
PVC

☐
☐

RMP (SR)
ABS

☐
☐

Wrought
Asbestos-Cement

☐
☐

Fiberglass
Concrete Tile

☐
☐

Other (Specify below) _____

Blank casing diameter 1 3/4 in. Was casing pulled? Yes ☐ No ☒ If yes, how much _____
Casing height above or below land surface -0- in.

6 GROUT PLUG MATERIAL: ☐ Neat cement ☒ Cement grout ☒ Bentonite ☐ Other _____

Grout Plug Intervals: From 22 ft. to 2 ft., From 2 ft. to 0 ft., From _____ ft. to _____ ft.

What is the nearest source of possible contamination:

☐
☐
☐
☐
☐

Septic tank
Sewer lines
Watertight sewer lines
Lateral lines
Cess pool

☐
☐
☐
☐
☐

Seepage pit
Pit privy
Sewage lagoon
Feedyard
Livestock pens

☐
☐
☐
☐
☐

Fuel storage
Fertilizer storage
Insecticide storage
Abandoned water well
Oil well/Gas well

☒ Other (specify below)well abandoned in pit

Direction from well? _____

How many feet? _____

FROM	TO	PLUGGING MATERIALS	FROM	TO	PLUGGING MATERIALS
<u>2</u>	<u>0</u>	<u>Cement</u>			
<u>22</u>	<u>2</u>	<u>Bentonite</u>			

7 CONTRACTOR'S OR LANDOWNER'S CERTIFICATION: This water well was plugged under my jurisdiction and was completed on (mo/day/year) 10/6/13 and this record is true to the best of my knowledge and belief. Kansas Water Well Contractor's License No. 628. This Water Well Record was completed on (mo/day/year) 10/2/13 under the business name of JM Enterprises by (signature) [Signature]

INSTRUCTIONS: Use typewriter or ballpoint pen. Please press firmly and print clearly. Please fill in blanks, underline or circle the correct answers. Send top three copies to Kansas Department of Health and Environment, Bureau of Water, Geology Section, 1000 SW Jackson St., Ste. 420, Topeka, Kansas 66612-1367. Telephone: 785/296-5524. Send one to Water Well Owner and retain one for your records. Visit us at <http://www.kdheks.gov/waterwell/index.html>.