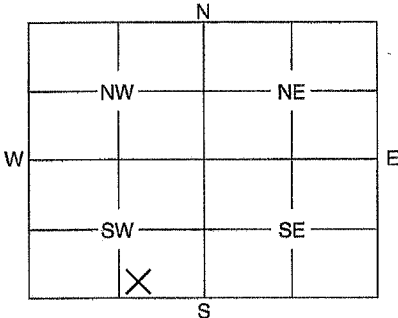


1	LOCATION OF WATER WELL:	Fraction	Section	Number	Township	Number	Range	Number
County:	Sedgwick	SW $\frac{1}{4}$ SE $\frac{1}{4}$ SW $\frac{1}{4}$	16		27		1	(E)W

Distance and direction from nearest town or city street address of well if located within city?

700 East Central, Wichita, KS 67202


2	WATER WELL OWNER: Steffen Dairy	RR #, St. Address, Box #: 700 E Central	Board of Agriculture, Division of Water Resources
	City, State, ZIP Code : Wichita, KS 67202	Application Number:	

3	MARK WELL'S LOCATION WITH AN "X" IN SECTION BOX:	4	DEPTH OF WELL 15.5 ft.
		WELL'S STATIC WATER LEVEL ft.	
		WELL WAS USED AS:	
		1 Domestic 5 Public Water Supply 9 Dewatering	
		2 Irrigation 6 Oil Field Water Supply 10 Monitoring Well	
		3 Feedlot 7 Domestic (Lawn & Garden) 11 Injection Well	
		4 Industrial 8 Air Conditioning 12 Other	
		Was a chemical / bacteriological sample submitted to Department? Yes No <input checked="" type="checkbox"/>	
		If yes, mo/day/yr sample was submitted	
		Water Well Disinfected: Yes No <input checked="" type="checkbox"/>	

5	TYPE OF BLANK CASING USED:
1 Steel 3 RMP (SR) 5 Wrought 7 Fiberglass 9 Other (Specify below)	
<input checked="" type="radio"/> 2 PVC 4 ABS 6 Asbestos-Cement 8 Concrete Tile	
Blank casing diameter 2 in. Was casing pulled? Yes <input checked="" type="checkbox"/> No If yes, how much 36"	
Casing height above or below land surface in.	

6	GROUT PLUG MATERIAL: 1 Neat cement 2 Cement grout <input checked="" type="radio"/> 3 Bentonite <input checked="" type="radio"/> 4 Other Native Soil
Grout Plug Intervals: From ft. to ft., From 3 ft. to 15.5 ft., From 0 to 15.5 ft.	
What is the nearest source of possible contamination:	
1 Septic tank 6 Seepage pit <input checked="" type="radio"/> 11 Fuel storage 16 Other (specify below)	
2 Sewer lines 7 Pit privy 12 Fertilizer storage	
3 Watertight sewer lines 8 Sewage lagoon 13 Insecticide storage	
4 Lateral lines 9 Feedyard 14 Abandoned water well	
5 Cess pool 10 Livestock pens 15 Oil well/Gas well	
Direction from well? How many feet?	

FROM	TO	PLUGGING MATERIALS
0	3	Native Soil
3	15.5	Bentonite

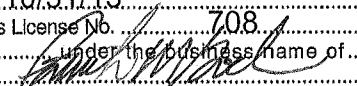7	CONTRACTOR'S OF LANDOWNER'S CERTIFICATION: This water well was plugged under my jurisdiction and was completed on (mo/day/year) 10/31/13 and this record is true to the best of my knowledge and belief. Kansas Water Well Contractor's License No. 708. This Water Well Record was completed on (mo/day/year) 11/29/13 under the business name of SCS Aquaterra
by (signature) 	

INSTRUCTIONS: Use typewriter or ball point pen. Please press firmly and print clearly. Please fill in blanks, underline or circle the correct answers. Send top three copies to Kansas Department of Health and Environment, Bureau of Water, Geology Section, 1000 SW Jackson St., Ste. 420, Topeka, Kansas 66612-1367. Telephone: 785/296-5522. Send one to Water Well Owner and retain one for your records.