

WATER WELL PLUGGING RECORD Form WWC-5P

KSA 82a-1212 ID NO.

1 LOCATION OF WATER WELL: Fraction SW 1/4 SW 1/4 NW 1/4 1/4 Section Number 19 Township Number T 27 S Range Number R 1 ☒ E ☐ W

Street/Rural Address of Well Location; if unknown, distance & direction from nearest town or intersection: If at owner's address, check here ☐

Basement - 2415 W Martha Wichita

2 WATER WELL OWNER: Margaret Cupps REV TR
RR#, St. Address, Box #: 14116 E Bauman RD
City, State ZIP Code: Haven KS 67543

Global Positioning Systems (GPS) information:

Latitude: _____ (in decimal degrees)

Longitude: _____ (in decimal degrees)

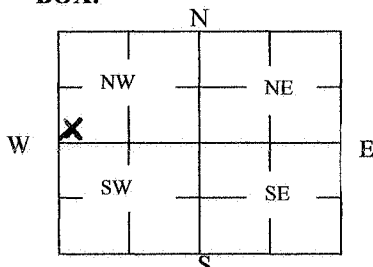
Elevation: _____

Datum: ☐ WGS84, ☐ NAD83, ☐ NAD27

Collection Method: _____

☐ GPS unit (Make/Model): _____☐ Digital Map/Photo, ☐ Topographic Map, ☐ Land SurveyEst. Accuracy: ☐ < 3 m, ☐ 3-5 m, ☐ 5-15 m, ☐ > 15 m

3 MARK WELL'S LOCATION WITH AN "X" IN SECTION BOX:

4 DEPTH OF WELL 25 ft.WELL'S STATIC WATER LEVEL 12 ft

WELL WAS USED AS:

☐
☐
☐
☐

Domestic
Irrigation
Feedlot
Industrial

☐
☒
☐
☐

Public Water Supply
Oil Field Water Supply
Domestic (Lawn & Garden)
Air Conditioning

☐
☐
☐
☐

Dewatering
Monitoring
Injection Well
Other _____

Was a chemical/bacteriological sample submitted to Department? Yes ☐ No ☒

5 TYPE OF BLANK CASING USED:

☒
☐

Steel
PVC

☐
☐

RMP (SR)
ABS

☐
☐

Wrought
Asbestos-Cement

☐
☐

Fiberglass
Concrete Tile

☐

Other (Specify below) _____

Blank casing diameter 1 3/4 in. Was casing pulled? Yes ☒ No ☐ If yes, how much _____Casing height above or below land surface 6 in.6 GROUT PLUG MATERIAL: ☐ Neat cement ☒ Cement grout ☒ Bentonite ☐ Other _____Grout Plug Intervals: From 12 ft. to 2 ft., From 2 ft. to 0 ft., From _____ ft. to _____ ft.

What is the nearest source of possible contamination:

☐
☒
☐
☐
☐

Septic tank
Sewer lines
Watertight sewer lines
Lateral lines
Cess pool

☐
☐
☐
☐
☐

Seepage pit
Pit privy
Sewage lagoon
Feedyard
Livestock pens

☐
☐
☐
☐
☐

Fuel storage
Fertilizer storage
Insecticide storage
Abandoned water well
Oil well/Gas well

☐ Other (specify below) _____Direction from well? Overhead
How many feet? 3 ft

FROM	TO	PLUGGING MATERIALS	FROM	TO	PLUGGING MATERIALS
<u>2</u>	<u>0</u>	<u>Cement</u>			
<u>12</u>	<u>2</u>	<u>Bentonite</u>			
<u>25</u>	<u>12</u>	<u>Sand</u>			

7 CONTRACTOR'S OR LANDOWNER'S CERTIFICATION: This water well was plugged under my jurisdiction and was completed on (mo/day/year) 12/7/13 and this record is true to the best of my knowledge and belief. Kansas Water Well Contractor's License No. 628. This Water Well Record was completed on (mo/day/year) 12/9/13 under the business name of JME Enterprises by (signature) [Signature]

INSTRUCTIONS: Use typewriter or ballpoint pen. Please press firmly and print clearly. Please fill in blanks, underline or circle the correct answers. Send top three copies to Kansas Department of Health and Environment, Bureau of Water, Geology Section, 1000 SW Jackson St., Ste. 420, Topeka, Kansas 66612-1367. Telephone: 785/296-5524. Send one to Water Well Owner and retain one for your records. Visit us at <http://www.kdheks.gov/waterwell/index.html>.