


WATER WELL RECORD Form WWC-5 KSA 82a-1212

1 LOCATION OF WATER WELL: Sedgwick	FRACTION SW 1/4 SE 1/4 NW 1/4	SECTION NUMBER 29	TOWNSHIP NUMBER T 27 S	RANGE NUMBER R 1E E/W
--	---	-----------------------------	----------------------------------	---------------------------------

Distance and direction from nearest town or city street address of well if located within city?
820 S. Osage **Wichita, Kansas**

2 WATER WELL OWNER: USD 259 Wichita Public School (West High School)	Board of Agriculture, Division of Water Resource
RR#,ST. ADDRESS,BOX #: 201 N. Water	Application Number: 20130790
CITY, STATE: Wichita, Kansas	ZIP CODE:

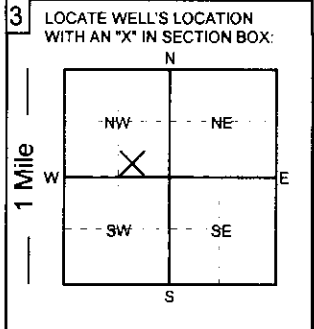

4 DEPTH OF WELL: **40** ft. ELEVATION:

Depth of groundwater Encountered: _____ ft.

WELL'S STATIC WATER LEVEL **14** FT. BELOW LAND SURFACE MEASURED ON **mo/day/yr: 2.14.14**

Pump test data: Well water was _____ ft. after _____ hours of pumping @ _____ gpm

Est. Yield: _____ gpm Well water was _____ ft. after _____ hours of pumping @ _____ gpm

Bore Hole Diameter **12** in. to _____ ft. and _____ in. to _____ ft.

WELL WATER USE USED AS:

1. Domestic	3. Feedlot	5. Public water supply	7. Lawn and garden only	9. Dewatering	11. Injection well
2. Irrigation	4. Industrial	6. Oil field water supply	8. Air conditioning	10. Monitoring well	12. Other (Specify below)

Was a chemical/bacteriological sample submitted to Department? **YES** **NO**; If yes, what mo/day/yr was sample submitted

Was Water Well Disinfected? **YES** **NO**

5 TYPE OF CASING USED:

1. Steel	3. RPM (SR)	5. Wrought Iron	7. Fiberglass	9. Other (Specify below)
<u>2. PVC</u>	4. ABS	6. Asbestos-Cement	8. Concrete tile	CASING JOINTS: <u>Welded</u> <u>Clamped</u>

Blank casing diameter **8** in. to _____ ft., Dia. in. to _____ ft., Dia. in. to _____ ft.

Casing height ~~to~~ land surface: **48** in., Weight: _____ lbs. / ft. Wall thickness or gauge No. _____

TYPE OF SCREEN OR PERFORATION MATERIAL:

1. Steel	3. Stainless Steel	5. Fiberglass	7. PVC	9. ABS	11. Other (specify)
2. Brass	4. Galvanized	6. Concrete Tile	8. RMP (SR)	10. Asbestos-Cement	12. None used (open hole)

SCREEN OR PERFORATION OPENINGS ARE:

1. Continuous slot	3. Mill slot	5. Gauzed wrapped	7. Torch cut	9. Drilled holes	11. None (open hole)
2. Louvered shutter	4. Key punched	6. Wire wrapped	8. Saw cut	10. Other (specify)	

SCREEN - PERFORATION INTERVAL From _____ ft. to _____ ft. From _____ ft. to _____ ft.

GRAVEL PACK INTERVALS: From _____ ft. to _____ ft. From _____ ft. to _____ ft.

6 GROUT MATERIALS: 1. Neat cement 2. Cement Grout 3. Bentonite Other bentonite hole plug

Grout Intervals: From _____ ft. to _____ ft., From _____ ft. to _____ ft., From _____ ft. to _____ ft., From **4** ft. to **24** ft.

What is the nearest source of possible contamination:

1. Septic tank	4. Lateral lines	7. Pit privy	10. Livestock pens	13. Insecticide storage	15. Oil well/Gas well
2. Sewer lines	5. Cess Pool	8. Sewage lagoon	11. Fuel storage	14. Abandon water well	16. Other (specify below)
3. Watertight sewer line	6. Seepage pit	9. Feed yard	12. Fertilizer storage		

Direction from well? _____ How many feet? _____

	From	To	LITHOLOGIC LOG		From	To	LITHOLOGIC LOG
					0	4	compactd clay
					4	24	bentonite hole plug
					24	40	chlorinated gravel

7 Contractor's or Landowner's Certification: This water well was 1. **constructed** 2. **reconstructed** or 3. **plugged** under my jurisdiction and was completed on (mo/day/year) **2/14/2014** and this record is true to the best of my knowledge and belief.

Kansas Water Well Contractor's License No. **236** This water well record was completed on (mo/day/year) **2/19/2014**

under the business name of **Harp Well and Pump Service** by (signature) **Todd S. Harp**