

**WATER WELL RECORD**

**Form WWC-5**


Division of Water Resources App. No.

<b>1 LOCATION OF WATER WELL:</b> County: Sedgwick	Fraction ¼ NW ¼ NE ¼ SE ¼	Section Number 22	Township No. T 27 S	Range Number R 1 <input checked="" type="checkbox"/> E <input type="checkbox"/> W
--	------------------------------	----------------------	------------------------	--

Street/Rural Address of Well Location; if unknown, distance & direction from nearest town or intersection: If at owner's address, check here .  
 Former Mikes Cleaners  
 2910 East Douglas, Wichita, KS 67203

**Global Positioning System (GPS) information:**  
 Latitude: 37.41' 8.74747" (in decimal degrees)  
 Longitude: 97 18' 9.22295" (in decimal degrees)  
 Elevation: 1303.63  
 Datum:  WGS 84,  NAD 83,  NAD 27  
 Collection Method:  
 GPS unit (Make/Model: .....)  
 Digital Map/Photo,  Topographic Map,  Land Survey  
 Est. Accuracy:  <3 m,  3-5 m,  5-15 m,  >15 m

**2 WATER WELL OWNER:** KDHE-BER  
 RR#, Street Address, Box #: 1000 SW Jackson St., Ste 410  
 City, State, ZIP Code : Topeka, KS 66612

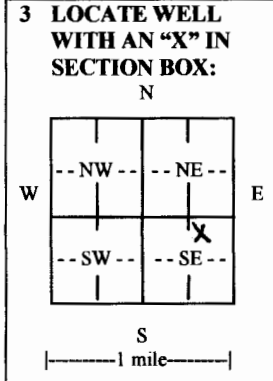

**4 DEPTH OF COMPLETED WELL** 35 ft.

Depth(s) Groundwater Encountered (1) 23.5 ft. (2) N/A ft. (3) N/A ft.

WELL'S STATIC WATER LEVEL 23.5 ft. below land surface measured on mo/day/yr. 3-4-2014

Pump test data: Well water was N/A ft. after N/A hours pumping. N/A gpm

EST. YIELD N/A gpm. Well water was N/A ft. after N/A hours pumping. N/A gpm

Bore Hole Diameter 8.25 in. to 35 ft., and N/A in. to N/A ft.

WELL WATER TO BE USED AS:  Public water supply  Geothermal  Injection well  
 Domestic  Feedlot  Oil field water supply  Dewatering  Other (Specify below)  
 Irrigation  Industrial  Domestic-lawn & garden  Monitoring well MW-2

Was a chemical/bacteriological sample submitted to Department?  Yes  No  
 If yes, mo/day/yr sample was submitted. N/A

Water well disinfected?  Yes  No

**5 TYPE OF CASING USED:**  Steel  PVC  Other

CASING JOINTS:  Glued  Clamped  Welded  Threaded  
 Casing diameter 2 in. to 20 ft., Diameter N/A in. to N/A ft., Diameter N/A in. to N/A ft.  
 Casing height above land surface 0 in., Weight N/A lbs./ft., Wall thickness or gauge No. Schedule 40

TYPE OF SCREEN OR PERFORATION MATERIAL:  
 Steel  Stainless Steel  PVC  Other (Specify) .....  
 Brass  Galvanized Steel  None used (open hole)

SCREEN OR PERFORATION OPENINGS ARE:  
 Continuous slot  Mill slot  Gauze wrapped  Torch cut  Drilled holes  None (open hole)  
 Louvered shutter  Key punched  Wire wrapped  Saw cut  Other (specify) .....

SCREEN-PERFORATED INTERVALS: From 20 ft. to 35 ft., From N/A ft. to N/A ft., From N/A ft. to N/A ft.  
 GRAVEL PACK INTERVALS: From 18 ft. to 35 ft., From N/A ft. to N/A ft., From N/A ft. to N/A ft.

**6 GROUT MATERIAL:**  Neat cement  Cement grout  Bentonite  Other Concrete 0-2 feet

Grout Intervals: From 2 ft. to 18 ft., From N/A ft. to N/A ft., From N/A ft. to N/A ft.

What is the nearest source of possible contamination:  
 Septic tank  Lateral lines  Pit privy  Livestock pens  Insecticide storage  Other (specify below)  
 Sewer lines  Cesspool  Sewage lagoon  Fuel storage  Abandoned water well  
 Watertight sewer lines  Seepage pit  Feedyard  Fertilizer storage  Oil well/gas well Chlorinated Solvents

Direction from well ..... Distance from well .....

FROM	TO	LITHOLOGIC LOG	FROM	TO	LITHO. LOG (cont.) or PLUGGING INTERVALS
0	1.0	Asphalt and very coarse sand	23.5	26.0	Sand very coarse saturated
1.0	2.5	silty clay dk brown slightly	26.0	30.0	Some small pebbles and gravel
2.5	6.5	moist stiff plastic	30.0	32.5	Some larger gravel 2 to 3/4 inch
2.5	6.5	clayey silt light brown slightly	32.5	34.0	Very weathered shale yellow brown to gray slightly moist very stiff angular blocky
6.5	9.5	moist trace plasticity			
6.5	9.5	silty clay dk brown slightly	34.0	38.0	Very weathered shale dk gray slightly moist very stiff angular
9.5	14.0	moist very stiff, plastic			
9.5	14.0	Trace fine sand encountered			blocky
14.0	19.5	fine sand slightly moist			
19.5	23.5	Sand med. to coarse slightly moist			Set well @ 35' (Auger refusal)

**7 CONTRACTOR'S OR LANDOWNER'S CERTIFICATION:** This water well was  constructed,  reconstructed, or  plugged under my jurisdiction and was completed on (mo/day/year) 3-4-2014 and this record is true to the best of my knowledge and belief.  
 Kansas Water Well Contractor's License No. 759 This Water Well Record was completed on (mo/day/year) 4-20-2014  
 under the business name of RAZEK Environmental, LLC by (signature) [Signature]

**INSTRUCTIONS:** Use typewriter or ball point pen. PLEASE PRESS FIRMLY and PRINT clearly. Please fill in blanks and check the correct answers. Send one copy to Kansas Department of Health and Environment, Bureau of Water, Geology Section, 1000 SW Jackson St., Suite 420, Topeka, Kansas 66612-1367. Telephone 785-296-5524. Send one copy to WATER WELL OWNER and retain one for your records. Include fee of \$5.00 for each constructed well. Visit us at