

WATER WELL RECORD

Form WWC-5

Division of Water Resources App. No.


1 LOCATION OF WATER WELL: County: Sedgwick	Fraction ¼ SE ¼ SE ¼ SE ¼	Section Number 27	Township No. T 27 S	Range Number R 1 <input checked="" type="checkbox"/> E <input type="checkbox"/> W
--	------------------------------	-----------------------------	------------------------	--

Street/Rural Address of Well Location; if unknown, distance & direction from nearest town or intersection: If at owner's address, check here .
Former Total #1855
3128 East Harry, Wichita, KS 67211

Global Positioning System (GPS) information:
Latitude: 37.66446 (in decimal degrees)
Longitude: 97.29965 (in decimal degrees)
Elevation: 1308.95
Datum: WGS 84, NAD 83, NAD 27

2 WATER WELL OWNER: KDHE-BER
RR#, Street Address, Box #: 1000 SW Jackson St., Ste 410
City, State, ZIP Code : Topeka, KS 66612

Collection Method:
 GPS unit (Make/Model:)
 Digital Map/Photo, Topographic Map, Land Survey
Est. Accuracy: <3 m, 3-5 m, 5-15 m, >15 m

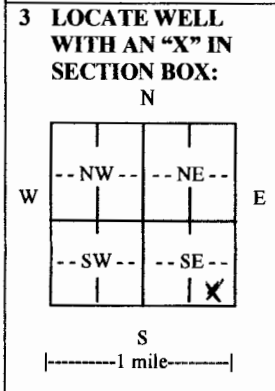

4 DEPTH OF COMPLETED WELL 40 ft.

Depth(s) Groundwater Encountered (1) 35 ft. (2) N/A ft. (3) N/A ft.

WELL'S STATIC WATER LEVEL 30.04 ft. below land surface measured on mo/day/yr. 4-10-2014

Pump test data: Well water was N/A ft. after N/A hours pumping N/A gpm
EST. YIELD N/A gpm. Well water was N/A ft. after N/A hours pumping N/A gpm

Bore Hole Diameter 8.25 in. to 40 ft., and N/A in. to N/A ft.

WELL WATER TO BE USED AS: Public water supply Geothermal Injection well
 Domestic Feedlot Oil field water supply Dewatering Other (Specify below)
 Irrigation Industrial Domestic-lawn & garden Monitoring well MW-12R

Was a chemical/bacteriological sample submitted to Department? Yes No
If yes, mo/day/yr sample was submitted N/A

Water well disinfected? Yes No

5 TYPE OF CASING USED: Steel PVC Other

CASING JOINTS: Glued Clamped Welded Threaded
Casing diameter 2 in. to 25 ft., Diameter N/A in. to N/A ft., Diameter N/A in. to N/A ft.
Casing height above land surface 0 in., Weight N/A lbs./ft., Wall thickness or gauge No. Schedule 40

TYPE OF SCREEN OR PERFORATION MATERIAL:
 Steel Stainless Steel PVC Other (Specify)
 Brass Galvanized Steel None used (open hole)

SCREEN OR PERFORATION OPENINGS ARE:
 Continuous slot Mill slot Gauze wrapped Torch cut Drilled holes None (open hole)
 Louvered shutter Key punched Wire wrapped Saw cut Other (specify)

SCREEN-PERFORATED INTERVALS: From 25 ft. to 40 ft., From N/A ft. to N/A ft., From N/A ft. to N/A ft.

GRAVEL PACK INTERVALS: From 23 ft. to 40 ft., From N/A ft. to N/A ft., From N/A ft. to N/A ft.

6 GROUT MATERIAL: Neat cement Cement grout Bentonite Other Concrete 0-2 feet

Grout Intervals: From 2 ft. to 23 ft., From N/A ft. to N/A ft., From N/A ft. to N/A ft.

What is the nearest source of possible contamination:
 Septic tank Lateral lines Pit privy Livestock pens Insecticide storage Other (specify below)
 Sewer lines Cesspool Sewage lagoon Fuel storage Abandoned water well
 Watertight sewer lines Seepage pit Feedyard Fertilizer storage Oil well/gas well

Direction from well **Northeast** Distance from well **240 feet**

FROM	TO	LITHOLOGIC LOG	FROM	TO	LITHO. LOG (cont.) or PLUGGING INTERVALS
0	0.5	4" Concrete, 2" gravel			plastic
0.5	11	CLAY reddish brown slightly moist stiff highly plastic	18	19	Medium SAND slightly moist some clay lenses
11	12.5	Sandy CLAY reddish brown slightly moist stiff highly plastic	19	22	Clayey SILT Brown moist soft trace plasticity
12.5	14	Silty CLAY reddish brown slightly moist stiff plastic	22	26	Medium SAND slightlv moist
14	16	Fine to medium SAND slightly moist reddish brown with some clay	26	28	Clayey SILT light brown very moist soft trace plasticity
16	18	Clayey SILT Brown moist soft med	28	29	CLAY light brown very moist soft
			29	40	Fine to medium SAND Moist

7 CONTRACTOR'S OR LANDOWNER'S CERTIFICATION: This water well was constructed, reconstructed, or plugged under my jurisdiction and was completed on (mo/day/year) 4-09-2014 and this record is true to the best of my knowledge and belief.
Kansas Water Well Contractor's License No. 759 This Water Well Record was completed on (mo/day/year) 5-18-2014 under the business name of RAZEK Environmental, LLC by (signature)

INSTRUCTIONS: Use typewriter or ball point pen. PLEASE PRESS FIRMLY and PRINT clearly. Please fill in blanks and check the correct answers. Send one copy to Kansas Department of Health and Environment, Bureau of Water, Geology Section, 1000 SW Jackson St., Suite 420, Topeka, Kansas 66612-1367. Telephone 785-296-5524. Send one copy to WATER WELL OWNER and retain one for your records. Include fee of \$5.00 for each constructed well. Visit us at <http://www.kdheks.gov/waterwell/index.html>