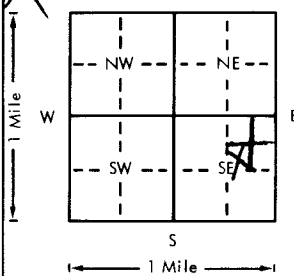
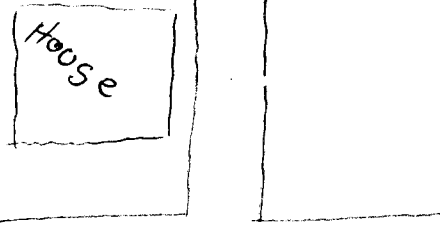


USE TYPEWRITER OR BALL
POINT PEN-PRESS FIRMLY,
PRINT CLEARLY.

WATER WELL RECORD
KSA 82a-1201-1215

Kansas Department of Health and
Environment-Division of Environment
(Water well Contractors)
Topeka, Kansas 66620

1. Location of well: County <u>Sedgwick</u> Section <u>SW-NE-SE</u> Township number <u>27</u> Range number <u>1</u>	
2. Distance and direction from nearest town or city: <u>Wichita</u> Street address of well location if in city: <u>1425 S. MAIN</u>	
3. Owner of well: <u>DEIBERT BROWN</u> R.R. or street: <u>1425 S. MAIN</u> City, state, zip code: <u>WICHITA, KS.</u>	
Locate with "X" in section below: 	
Sketch map: 	
5. Type and color of material	
From To	
<u>Topsoil</u> 0 10	
<u>Dirt-Sandy</u> 11 18	
<u>SAND - FINE - MED.</u> 19 25	
<u>GRAVEL - Coarse</u> 26 30	
6. Bore hole dia. <u>11</u> in. Completion date <u>7-25-78</u> Well depth <u>30</u> ft.	
7. <input type="checkbox"/> Cable tool <input type="checkbox"/> Rotary <input checked="" type="checkbox"/> Driven <input type="checkbox"/> Dug <input type="checkbox"/> Hollow rod <input type="checkbox"/> Jetted <input checked="" type="checkbox"/> Bored <input type="checkbox"/> Reverse rotary	
8. Use: <input type="checkbox"/> Domestic <input type="checkbox"/> Public supply <input type="checkbox"/> Industry <input checked="" type="checkbox"/> Irrigation <input type="checkbox"/> Air conditioning <input type="checkbox"/> Stock <input checked="" type="checkbox"/> Lawn <input type="checkbox"/> Oil field water <input type="checkbox"/> Other	
9. Casing: Material <u>PVC</u> Height: Above or below Threaded <input type="checkbox"/> Welded <input type="checkbox"/> Surface <u>12</u> in. RMP <input type="checkbox"/> PVC <input checked="" type="checkbox"/> Weight <u>2758</u> lbs./ft. Dia. <u>5</u> in. to <u> </u> ft. depth Wall Thickness: inches or Dia. <u> </u> in. to <u> </u> ft. depth gage No. <u>1258</u>	
10. Screen: Manufacturer's name <u>Modern</u> Type <u>Wire</u> Dia. <u>5.563</u> Slot/gauze <u>.025</u> Length <u>5</u> Set between <u>25</u> ft. and <u>30</u> ft. ft. and <u> </u> ft. Gravel pack? <u>No</u> Size range of material <u> </u>	
11. Static water level: <u>18</u> ft. below land surface Date <u>7-25-78</u> mo./day/yr.	
12. Pumping level below land surfaces: <u>18</u> ft. after <u>1</u> hrs. pumping <u>20</u> g.p.m. ft. after <u> </u> hrs. pumping <u> </u> g.p.m. Estimated maximum yield <u>50</u> g.p.m.	
13. Water sample submitted: <u> </u> mo./day/yr. <input type="checkbox"/> Yes <input checked="" type="checkbox"/> No Date <u> </u>	
14. Well head completion: <input type="checkbox"/> Pitless adapter <u>12</u> Inches above grade	
15. Well grouted? <u>YES</u> With: <input checked="" type="checkbox"/> Neat cement <input type="checkbox"/> Bentonite <input type="checkbox"/> Concrete Depth: From <u>0</u> ft. to <u>10</u> ft.	
16. Nearest source of possible contamination: ft. <u>45</u> Direction <u>W</u> Type <u>SEWER</u> Well disinfected upon completion? <input checked="" type="checkbox"/> Yes <input type="checkbox"/> No	
17. Pump: <input checked="" type="checkbox"/> Not installed Manufacturer's name <u> </u> Model number <u> </u> HP <u> </u> Volts <u> </u> Length of drop pipe <u> </u> ft. capacity <u> </u> g.p.m. Type: <input type="checkbox"/> Submersible <input type="checkbox"/> Turbine <input type="checkbox"/> Jet <input type="checkbox"/> Reciprocating <input type="checkbox"/> Centrifugal <input type="checkbox"/> Other	
(Use a second sheet if needed)	
18. Elevation: Topography: <input type="checkbox"/> Hill <input type="checkbox"/> Slope <input type="checkbox"/> Upland <input checked="" type="checkbox"/> Valley	19. Remarks: 20. Water well contractor's certification: This well was drilled under my jurisdiction and this report is true to the best of my knowledge and belief. <u>21st Electric</u> <u>129</u> Business name License No. Address <u>512 W 21 / Wichita</u> Signed <u>J. Harris</u> Date <u>8-22-78</u> Authorized representative

Forward the white, blue and pink copies to the Department of Health and Environment

Form WWC-5