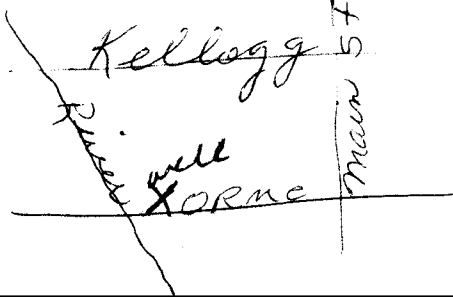


USE TYPEWRITER OR BALL  
POINT PEN-PRESS FIRMLY,  
PRINT CLEARLY.

WATER WELL RECORD  
KSA 82a-1201-1215

Kansas Department of Health and  
Environment-Division of Environment  
(Water well Contractors)  
Topeka, Kansas 66620

SE NW NE NE

1. Location of well:		County <b>Sedgwick</b>	Fraction <b>SW 1/4 Sec 14 T 27 S R 1</b>	Section number <b>29</b>	Township number <b>27</b>	Range number <b>1</b>
2. Distance and direction from nearest town or city: Street address of well location if in city: <b>120 Orme</b>				3. Owner of well: R.R. or street: City, state, zip code: <b>Roy Parnell 120 Orme Wichita KS</b>		
4. Locate with "X" in section below: N W E S 1 Mile		Sketch map: 		6. Bore hole dig. <b>8</b> in. Completion date <b>7/13/77</b> Well depth <b>30</b> ft.		
5. Type and color of material		From	To	7. Cable tool <input checked="" type="checkbox"/> Rotary <input type="checkbox"/> Driven <input type="checkbox"/> Dug <input type="checkbox"/> Hollow rod <input type="checkbox"/> Jetted <input type="checkbox"/> Bored <input type="checkbox"/> Reverse rotary		
<b>Black Dirt</b>		<b>0</b>	<b>7</b>	8. Use: <input checked="" type="checkbox"/> Domestic <input type="checkbox"/> Public supply <input type="checkbox"/> Industry <input checked="" type="checkbox"/> Irrigation <input type="checkbox"/> Air conditioning <input type="checkbox"/> Stock <input type="checkbox"/> Lawn <input type="checkbox"/> Oil field water <input type="checkbox"/> Other		
<b>Yellow Sand</b>		<b>7</b>	<b>16</b>	9. Casing: Material <b>Steel</b> Weight <b>12</b> lbs./ft. Threaded <input type="checkbox"/> Welded <input type="checkbox"/> Surface <b>12</b> in. RMP <input type="checkbox"/> PVC <input type="checkbox"/> Weight <b>100</b> lbs./ft. Dia. <b>4</b> in. to <b>30</b> ft. depth Wall Thickness: inches or Dia. <input type="checkbox"/> in. to <input type="checkbox"/> ft. depth gage No. <b>100</b>		
<b>White Sand</b>		<b>16</b>	<b>30</b>	10. Screen: Manufacturer's name <b>Sun Flower</b> Type <b>100</b> Dia. <b>4"</b> Slot/gauze <b>Slot</b> Length <b>5'</b> Set between <b>25</b> ft. and <b>30</b> ft. ft. and ft. Gravel pack? <b>No</b> Size range of material <b>5"</b>		
				11. Static water level: <b>16</b> ft. below land surface Date <b>7/13/77</b> mo./day/yr.		
				12. Pumping level below land surfaces: ft. after hrs. pumping g.p.m. ft. after hrs. pumping g.p.m. Estimated maximum yield <b>10</b> g.p.m.		
				13. Water sample submitted: mo./day/yr. Yes <input checked="" type="checkbox"/> No <input type="checkbox"/> Date		
				14. Well head completion: Pitless adapter <b>12</b> inches above grade		
				15. Well grouted? <b>yes</b> With: <input checked="" type="checkbox"/> Neat cement <input type="checkbox"/> Bentonite <input type="checkbox"/> Concrete Depth: From <b>0</b> ft. to <b>10</b> ft.		
				16. Nearest source of possible contamination: ft. <b>50</b> Direction <b>East</b> Type <b>sewer</b> Well disinfected upon completion? <input checked="" type="checkbox"/> Yes <input type="checkbox"/> No		
				17. Pump: <input checked="" type="checkbox"/> Not installed Manufacturer's name Model number HP Volts Length of drop pipe ft. capacity g.p.m. Type: <input type="checkbox"/> Submersible <input type="checkbox"/> Turbine <input type="checkbox"/> Jet <input type="checkbox"/> Reciprocating <input type="checkbox"/> Centrifugal <input type="checkbox"/> Other		
		(Use a second sheet if needed)				
18. Elevation: Topography: <input type="checkbox"/> Hill <input type="checkbox"/> Slope <input checked="" type="checkbox"/> Upland <input type="checkbox"/> Valley		19. Remarks:		20. Water well contractor's certification: This well was drilled under my jurisdiction and this report is true to the best of my knowledge and belief. <b>Jet Drilling 313</b> Business name <b>257 N Sabin</b> License No. Address <b>Wing &amp; Sandran</b> Date <b>7/13/77</b> Signed <b>Wing &amp; Sandran</b> Authorized representative		

Forward the white, blue and pink copies to the Department of Health and Environment

Form WWC-5