


Approx. 315' N, 20' W of Douglas Ave. & Mead St. – Wichita

Application Number:

20 ft. ELEVATION: **1299.09 (TOC)**

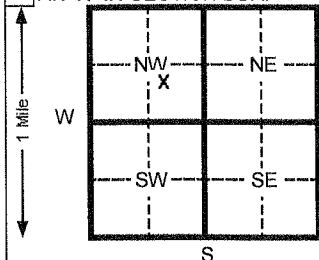

Was a chemical/bacteriological sample submitted to Department? Yes No **X** If yes, mo/day/yr sample was

Was a chemical/bacteriological sample submitted to Department? Yes _____ No **X** If yes, mo/day/yr sample was submitted _____
Water Well Disinfected? Yes _____ No **X**

7. Fiberglass		Threaded		Flange	

Casing height above land surface	0	in., weight	0.703	lbs./ft. Wall thickness or gauge No.	SCH. 40
----------------------------------	---	-------------	-------	--------------------------------------	---------

7 PVC	10 Asbestos-cement
-------	--------------------

1 Continuous slot 3 Mill slot 6 Wire wrapped 9 Drilled holes

2 Louvered shutter 4 Key punched 7 Torch cut 10 Other (specify) _____

From	ft. to	ft. From	ft. to	ft.
------	--------	----------	--------	-----

GRAVEL PACK INTERVALS: From **8** ft. to **20** ft. From _____ ft. to _____ ft.

	From	ft to	ft From	ft to	ft
--	------	-------	---------	-------	----

6	GROUT MATERIAL:	1 Neat cement	2 Cement grout	3 Bentonite	4 Other
---	-----------------	---------------	----------------	-------------	---------

3 GROUT MATERIAL:	1 Neat cement	2 Cement grout	3 Bentonite	4 Other
5	1	2	3	4

Grout Intervals From _____ ft. to _____ ft. From _____ ft. to _____ ft. From _____ ft. to _____ ft. From _____ ft. to _____ ft.

What is the nearest source of possible contamination:	10 Livestock pens	14 Abandoned water well
1. Gas tank	11. Fuel tanks	15. Oil well/ Gas well

1 Septic tank	4 Lateral lines	7 Pit privy	11 Fuel storage	15 Oil well/ Gas well
2 Sewer lines	5 Cesspits	8 Composting	12 Fuel utilization	16 Other (specify below)

2 Sewer lines	5 Cess pool	8 Sewage lagoon	12 Fertilizer storage	16 Other (specify below)
3 Water distribution	6 " "	9 " "	13 Insecticide storage	

3 Watertight sewer lines	6 Seepage pit	9 Feedyard	13 Insecticide storage
4 " " "	7 " " "	10 " " "	14 " " "

Direction from well?				How many feet?		
FROM	TO	CODE	LITHOLOGIC LOG	FROM	TO	PLUGGING INTERVALS

FROM	TO	CODE	LITHOLOGIC LOG	FROM	TO	PLUGGING INTERVALS
0	5		Brick surface; Lithology not logged			

5	6.5	Clayey Silt brown			
---	-----	-------------------	--	--	--

6.5	11	Silty Clay, brown to light brown			
-----	----	----------------------------------	--	--	--

11	13.5	Silt - light brown			
----	------	--------------------	--	--	--

		Sand, brown to brown gray, poorly			

13.5	17.5	Sand, brown to brown gray, poorly graded, fine		
------	------	--	--	--

			Sand , brown, poorly graded, fine to		
--	--	--	---	--	--

17.5	20	medium			
------	----	--------	--	--	--

--	--	--	--	--	--	--

[illegible][illegible][illegible]

					Easting: 1651181.81
--	--	--	--	--	---------------------

7 CONTRACTOR'S OR LANDOWNER'S CERTIFICATION: This water well was (1) constructed, (2) reconstructed, or (3) plugged under my jurisdiction and was

completed on (mo/day/yr) 05/21/14 and this record is true to the best of my knowledge and belief. Kansas

Water Well Contractor's License No. **531** This Water Well Record was completed on (mo/day/yr) **07/21/14**

under the business name of **GSI Engineering, LLC** by (signature)

INSTRUCTIONS: Please fill in blanks and circle the correct answers. Send three copies to Kansas Department of Health and Environment, Bureau of Water, 1000 S W Jackson St., Ste. 420, Topeka, Kansas 66612-1367. Telephone: 913-296-5545. Send one to WATER WELL OWNER and retain one for your records.