

WATER WELL RECORD

Form WWC-5

Division of Water Resources App No


MW-1

1 LOCATION OF WATER WELL: County: Sedgwick Fraction: NW 1/4 NW 1/4 NW 1/4 NW 1/4 Section Number: 2813 Township No: T 27 S Range Number: R 1 E W

Street/Rural Address of Well Location; if unknown, distance & direction from nearest town or intersection. If at owner's address, check here
1350 N. Oliver Avenue, Wichita, KS 67208

Global Positioning System (GPS) information:
 Latitude: ~~37.7061~~ 37.7060 (in decimal degrees)
 Longitude: ~~97.2809~~ 97.2828 (in decimal degrees)
 Elevation: 1376.40 TOC
 Datum: WGS 84, NAD 83, NAD 27
 Collection Method:
 GPS unit (Make/Model: Garmin Earth)
 Digital Map/Photo, Topographic Map, Land Survey
 Est. Accuracy: < 3 m, 3-5 m, 5-15 m, > 15 m

2 WATER WELL OWNER: The Pantry, Inc.
 RR#, Street Address, Box #: 305 Greason Drive
 City, State, ZIP Code: Cary, NC 27512

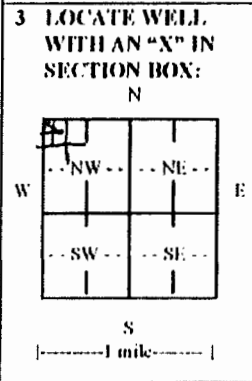

4 DEPTH OF COMPLETED WELL 25.0' ft.

Depth(s) Groundwater Encountered (1) 20.0' ft. (2)..... ft. (3)..... ft.

WELL'S STATIC WATER LEVEL 20.24 ft. below land surface measured on mo/day/yr DATA 8/07/14

Pump test data: Well water was..... ft. after..... hours pumping..... gpm

EST. YIELD..... gpm. Well water was..... ft. after..... hours pumping..... gpm

Bore Hole Diameter 6.50" in. to 25.0' ft., and..... in. to..... ft.

WELL WATER (TO BE USED) AS: Public water supply Geothermal Injection well
 Domestic Feedlot Oil field water supply Dewatering Other (Specify below)
 Irrigation Industrial Domestic-lawn & garden Monitoring well

Was a chemical/bacteriological sample submitted to Department? Yes No

If yes, mo/day/yr sample was submitted.....

Water well disinfected? Yes No

5 TYPE OF CASING USED: Steel PVC Other.....

CASING JOINTS: Glued Clamped Welded Threaded

Casing diameter 2.0" in. to 5.0' ft., Diameter..... in. to..... ft., Diameter..... in. to..... ft.

Casing height above land surface Flush in., Weight..... lbs./ft., Wall thickness or gauge No. Sch. 40

TYPE OF SCREEN OR PERFORATION MATERIAL:
 Steel Stainless Steel PVC Other (Specify).....
 Brass Galvanized Steel None used (open hole)

SCREEN OR PERFORATION OPENINGS ARE:
 Continuous slot Mill slot Gauze wrapped Torch cut Drilled holes None (open hole)
 Louvered shutter Key punched Wire wrapped Saw cut Other (specify).....

SCREEN-PERFORATED INTERVALS: From 5.0' ft. to 25.0' ft., From..... ft. to..... ft.
 From..... ft. to..... ft., From..... ft. to..... ft.

GRAVEL PACK INTERVALS: From 4.0' ft. to 25.0' ft., From..... ft. to..... ft.
 From..... ft. to..... ft., From..... ft. to..... ft.

6 GROUT MATERIAL: Neat cement Cement grout Bentonite Other.....

Grout Intervals From 1.0' ft. to 4.0' ft., From..... ft. to..... ft., From..... ft. to..... ft.

What is the nearest source of possible contamination:
 Septic tank Lateral lines Pit privy Livestock pens Insecticide storage Other (specify below)
 Sewer lines Cesspool Sewage lagoon Fuel storage Abandoned water well
 Watertight sewer lines Seepage pit Feedyard Fertilizer storage Oil well/gas well

Direction from well..... Distance from well.....

| FROM | TO | LITHOLOGIC LOG | FROM | TO | LITHO. LOG (cont.) or PLUGGING INTERVALS |
|------|----|----------------|------|----|--|
| | | See Boring Log | | | |
| | | | | | |
| | | | | | |
| | | | | | |
| | | | | | |
| | | | | | |
| | | | | | |
| | | | | | |
| | | | | | |

7 CONTRACTOR'S OR LANDOWNER'S CERTIFICATION: This water well was constructed, reconstructed, or plugged under my jurisdiction and was completed on (mo/day/year) 07/31/2014... and this record is true to the best of my knowledge and belief. Kansas Water Well Contractor's License No. 606... This Water Well Record was completed on (mo/day/year) 08/25/2014 under the business name of PSA Environmental by (signature).....

INSTRUCTIONS: Use typewriter or ball point pen. PLEASE PRESS FIRMLY and PRINT clearly. Please fill in blanks and check the correct answers. Send three copies (white, blue, pink) to Kansas Department of Health and Environment, Bureau of Water, Geology Section, 1000 SW Jackson St., Suite 420, Topeka, Kansas 66612-1367 Telephone 785-296-5522. Send one copy to WATER WELL OWNER and retain one for your records. Include fee of \$5.00 for each constructed well. Visit us at <http://www.kdheks.gov/waterwell/index.html>.

