


**WATER WELL RECORD**

**Form WWC-5**

Division of Water Resources App. No.  

<b>1 LOCATION OF WATER WELL:</b> County: Sedgwick	Fraction NW 1/4 SW 1/4 NW 1/4 NE 1/4	Section Number 35	Township No. T 27 S	Range Number R 1 <input checked="" type="checkbox"/> E <input type="checkbox"/> W
Street/Rural Address of Well Location; if unknown, distance & direction from nearest town or intersection: If at owner's address, check here <input type="checkbox"/>  McDonalds 1630 South Hillside Street, Wichita, KS 67211		<b>Global Positioning System (GPS) information:</b> Latitude: 37.67348 (in decimal degrees) Longitude: 97.29863 (in decimal degrees) Elevation: 1308.79 Datum: <input type="checkbox"/> WGS 84, <input checked="" type="checkbox"/> NAD 83, <input type="checkbox"/> NAD 27 Collection Method: <input type="checkbox"/> GPS unit (Make/Model: .....) <input type="checkbox"/> Digital Map/Photo, <input type="checkbox"/> Topographic Map, <input checked="" type="checkbox"/> Land Survey Est. Accuracy: <input checked="" type="checkbox"/> <3 m, <input type="checkbox"/> 3-5 m, <input type="checkbox"/> 5-15 m, <input type="checkbox"/> >15 m		

<b>2 WATER WELL OWNER:</b> RR#, Street Address, Box #: KDHE-BER 1000 SW Jackson St., Ste 410 City, State, ZIP Code : Topeka, KS 66612	
---	--

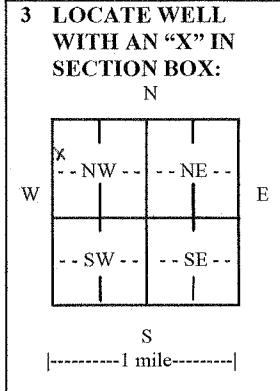

**4 DEPTH OF COMPLETED WELL** 45 ft.

Depth(s) Groundwater Encountered (1) 36 ft. (2) N/A ft. (3) N/A ft.

WELL'S STATIC WATER LEVEL..... ft. below land surface measured on mo/day/yr.....

Pump test data: Well water was N/A ft. after N/A hours pumping N/A gpm

EST. YIELD N/A gpm. Well water was N/A ft. after N/A hours pumping N/A gpm

Bore Hole Diameter 8.25 in. to 4.5 ft., and N/A in. to N/A ft.

WELL WATER TO BE USED AS:  Public water supply  Geothermal  Injection well  
 Domestic  Feedlot  Oil field water supply  Dewatering  Other (Specify below)  
 Irrigation  Industrial  Domestic-lawn & garden  Monitoring well MW-39

Was a chemical/bacteriological sample submitted to Department?  Yes  No  
 If yes, mo/day/yr sample was submitted N/A

Water well disinfected?  Yes  No

**5 TYPE OF CASING USED:**  Steel  PVC  Other

CASING JOINTS:  Glued  Clamped  Welded  Threaded

Casing diameter 2 in. to 30 ft., Diameter N/A in. to N/A ft., Diameter N/A in. to N/A ft.

Casing height above land surface 0 in., Weight N/A lbs./ft., Wall thickness or gauge No. Schedule 40

TYPE OF SCREEN OR PERFORATION MATERIAL:  
 Steel  Stainless Steel  PVC  Other (Specify) .....  
 Brass  Galvanized Steel  None used (open hole)

SCREEN OR PERFORATION OPENINGS ARE:  
 Continuous slot  Mill slot  Gauze wrapped  Torch cut  Drilled holes  None (open hole)  
 Louvered shutter  Key punched  Wire wrapped  Saw cut  Other (specify) .....

SCREEN-PERFORATED INTERVALS: From 30 ft. to 45 ft., From N/A ft. to N/A ft., From N/A ft. to N/A ft.

GRAVEL PACK INTERVALS: From 28 ft. to 45 ft., From N/A ft. to N/A ft., From N/A ft. to N/A ft.

**6 GROUT MATERIAL:**  Neat cement  Cement grout  Bentonite  Other Concrete 0 to 2-feet

Grout Intervals: From 2 ft. to 28 ft., From N/A ft. to N/A ft., From N/A ft. to N/A ft.

What is the nearest source of possible contamination:  
 Septic tank  Lateral lines  Pit privy  Livestock pens  Insecticide storage  Other (specify below)  
 Sewer lines  Cesspool  Sewage lagoon  Fuel storage  Abandoned water well  
 Watertight sewer lines  Seepage pit  Feedyard  Fertilizer storage  Oil well/gas well

Direction from well ..... Distance from well .....

FROM	TO	LITHOLOGIC LOG	FROM	TO	LITHO. LOG (cont.) or PLUGGING INTERVALS
0	1	Asphalt gravel sand	32	36	Clayey sand lt brown moist
1	4	Silty clay very dk brown moist med stiff plastic	36	38.5	med to coarse grained sand clayey sand coarse to medium grain
4	12	clay brown slightly moist med stiff plastic	38.5	45	very moist dark brownish gray sand med to coarse saturated dark gray
12	17	" " highly plastic			
17	28	" " lt brown silty moist med stiff plastic			
28	32	Sandy clay lt brown moist plastic med stiff			

**7 CONTRACTOR'S OR LANDOWNER'S CERTIFICATION:** This water well was  constructed,  reconstructed, or  plugged under my jurisdiction and was completed on (mo/day/year) 9-2-14 and this record is true to the best of my knowledge and belief. Kansas Water Well Contractor's License No. 759. This Water Well Record was completed on (mo/day/year) 8-26-2014 under the business name of RAZEK Environmental, LLC by (signature) *David J. Rauter*

**INSTRUCTIONS:** Use typewriter or ball point pen. PLEASE PRESS FIRMLY and PRINT clearly. Please fill in blanks and check the correct answers. Send one copy to Kansas Department of Health and Environment, Bureau of Water, Geology Section, 1000 SW Jackson St., Suite 420, Topeka, Kansas 66612-1367. Telephone 785-296-5524. Send one copy to WATER WELL OWNER and retain one for your records. Include fee of \$5.00 for each constructed well. Visit us at <http://www.kdheks.gov/waterwell/index.html>