

County: Sedgwick Fraction NE NE NW NE Sec. 5 T 27 S R 1 EW

CORRECTION(S) TO WATER WELL COMPLETION RECORD (WWC-5)

(to rectify lacking or incorrect information)

Owner: Perry Duncan

Location was listed as:

Section-Township-Range: None Given

Fraction (1/4 1/4 1/4): _____

Location changed to:

5-27S-1E

NE NE NW NE

Other changes: Initial statements: _____

Changed to: _____

Comments: _____


(using WGS84 datum)

Verification method: Latitude & longitude, KGS' "LEO" conversion tool, wellsite address & city street map, and mapping tool & aerial photos on KGS website. initials: DR date: 2/4/2015

Submitted by: Kansas Geological Survey, Data Resources Library, 1930 Constant Ave., Lawrence, KS 66047-3726
to: Kansas Dept of Health & Environment, Bureau of Water, 1000 SW Jackson, Suite 420, Topeka, KS 66612-1367.


345 29th Street N

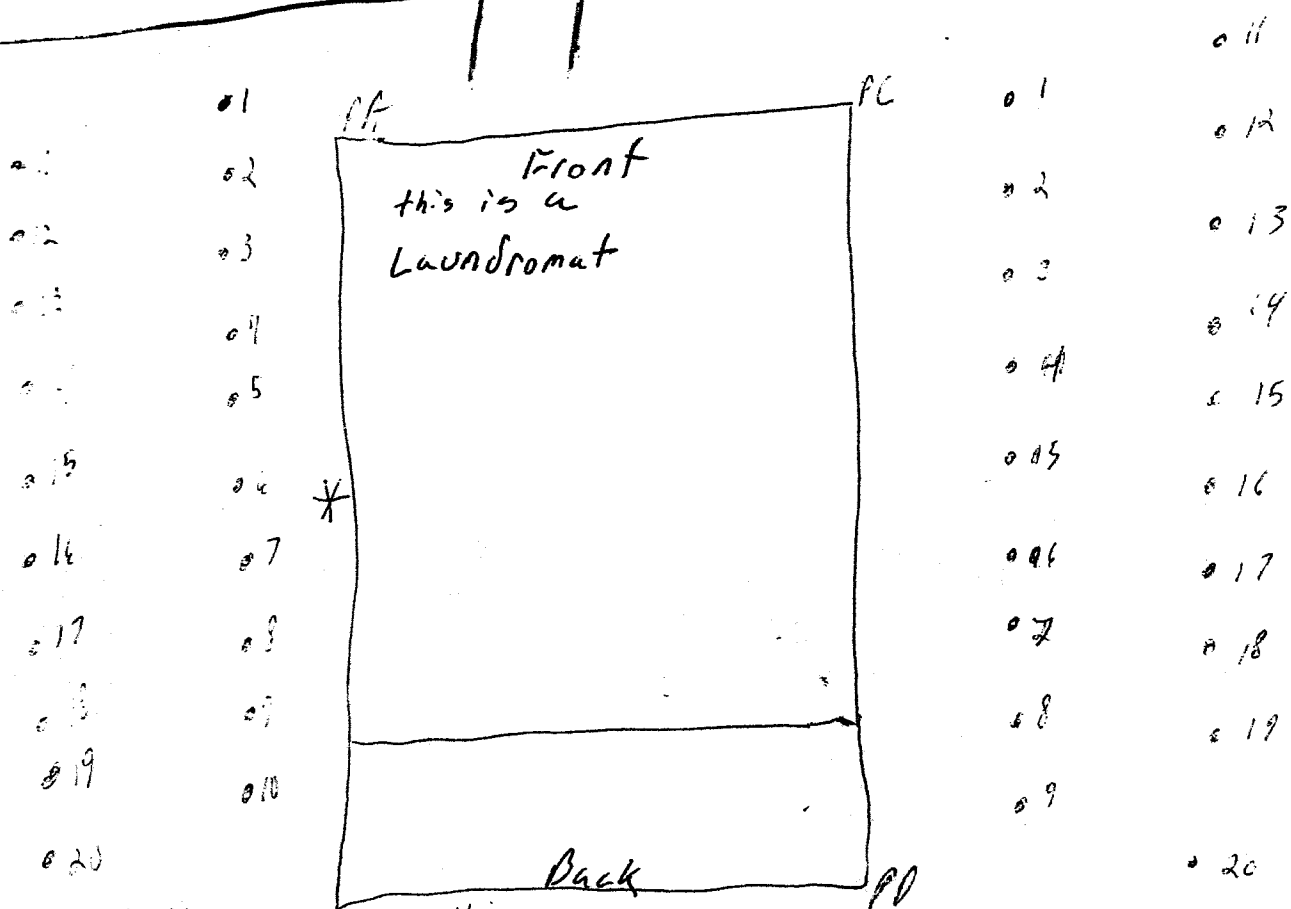

GPS *
 37° 41' 12" N
 97° 20' 29" W

- cities
- wichita, KS 3.4° S
- Park city, KS 4.3° N
- Del Aire, KS 4.7° NE
- Kechi, KS 5.3° NE

