

WATER WELL RECORD Form WWC-5


Division of Water Resources App. No.

Well ID

Original Record Correction Change in Well Use

1 LOCATION OF WATER WELL: County: Sedgwick Fraction: $\frac{1}{4}$ NW $\frac{1}{4}$ NW $\frac{1}{4}$ Section Number: 25 Township Number: T 27 S Range Number: R 1 E W

2 WELL OWNER: Last Name: BP Products North America First: Street or Rural Address where well is located (if unknown, distance and direction from nearest town or intersection): If at owner's address, check here:
 Business: BP Products North America Address: 28100 Torch Parkway Former Amoco #9513
 Address: City: Warrenville State: IL ZIP: 60555 514 South Oliver Street, Wichita, KS 67218

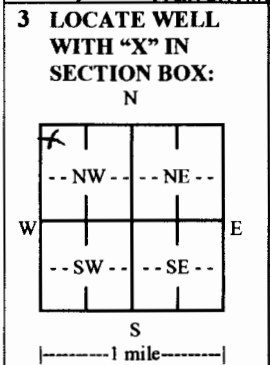

4 DEPTH OF COMPLETED WELL: 20 ft.
 Depth(s) Groundwater Encountered: 1) 15 ft.
 2) N/A ft. 3) N/A ft., or 4) Dry Well
 WELL'S STATIC WATER LEVEL: 18.10 ft.
 below land surface, measured on (mo-day-yr) 4/9/2015
 above land surface, measured on (mo-day-yr) N/A
 Pump test data: Well water was N/A ft.
 after N/A hours pumping N/A gpm
 Well water was N/A ft.
 after N/A hours pumping N/A gpm
 Estimated Yield: N/A gpm
 Bore Hole Diameter: 8.25 in. to 20 ft. and
N/A in. to N/A ft.

5 Latitude: 37.67871 (decimal degrees)
Longitude: 97.27985 (decimal degrees)
 Horizontal Datum: WGS 84 NAD 83 NAD 27
Source for Latitude/Longitude:
 GPS (unit make/model:)
 (WAAS enabled? Yes No)
 Land Survey Topographic Map
 Online Mapper:

6 Elevation: 1357.54 ft. Ground Level TOC
 Source: Land Survey GPS Topographic Map
 Other

7 WELL WATER TO BE USED AS:

1. Domestic: Household Lawn & Garden Livestock
 2. Irrigation
 3. Feedlot
 4. Industrial
 5. Public Water Supply: well ID
 6. Dewatering: how many wells?
 7. Aquifer Recharge: well ID
 8. Monitoring: well ID MW-118
 9. Environmental Remediation: well ID
 Air Sparge Soil Vapor Extraction
 Recovery Injection
 10. Oil Field Water Supply: lease
 11. Test Hole: well ID
 Cased Uncased Geotechnical
 12. Geothermal: how many bores?
 a) Closed Loop Horizontal Vertical
 b) Open Loop Surface Discharge Inj. of Water
 13. Other (specify):

Was a chemical/bacteriological sample submitted to KDHE? Yes No If yes, date sample was submitted: N/A
 Water well disinfected? Yes No

8 TYPE OF CASING USED: Steel PVC Other CASING JOINTS: Glued Clamped Welded Threaded
 Casing diameter 2 in. to 5 ft., Diameter N/A in. to N/A ft., Diameter N/A in. to N/A ft.
 Casing height above land surface 0 in. Weight N/A lbs./ft. Wall thickness or gauge No. Sch 40

TYPE OF SCREEN OR PERFORATION MATERIAL:
 Steel Stainless Steel Fiberglass PVC Other (Specify)
 Brass Galvanized Steel Concrete tile None used (open hole)

SCREEN OR PERFORATION OPENINGS ARE:
 Continuous Slot Mill Slot Gauze Wrapped Torch Cut Drilled Holes Other (Specify)
 Louvered Shutter Key Punched Wire Wrapped Saw Cut None (Open Hole)

SCREEN-PERFORATED INTERVALS: From 5 ft. to 20 ft., From N/A ft. to N/A ft., From N/A ft. to N/A ft.
 GRAVEL PACK INTERVALS: From 4 ft. to 20 ft., From N/A ft. to N/A ft., From N/A ft. to N/A ft.

9 GROUT MATERIAL: Neat cement Cement grout Bentonite Other Concrete 0-2 feet
 Grout Intervals: From 2 ft. to 4 ft., From N/A ft. to N/A ft., From N/A ft. to N/A ft.

Nearest source of possible contamination:
 Septic Tank Lateral Lines Pit Privy Livestock Pens Insecticide Storage
 Sewer Lines Cess Pool Sewage Lagoon Fuel Storage Abandoned Water Well
 Watertight Sewer Lines Seepage Pit Feedyard Fertilizer Storage Oil Well/Gas Well
 Other (Specify)
 Direction from well? Distance from well? ft.

10 FROM	TO	LITHOLOGIC LOG	FROM	TO	LITHO. LOG (cont.) or PLUGGING INTERVALS
0	1.5	Concrete	11	16	green-gray silt some sand moist
1.5	2	Fill - gray silt			to wet IR plastic, med.
2	5	brn silty clay, damp IR plastic	16	20	lt brn clay, moist, plastic
		stiff			soft
5	9	pink and tan clay some			
		limestone gravels damp			
		non plastic stiff			
9	11	brn sandy silt damp non-			
		plastic stiff			

11 CONTRACTOR'S OR LANDOWNER'S CERTIFICATION: This water well was constructed, reconstructed, or plugged under my jurisdiction and was completed on (mo-day-year) 4-2-15 and this record is true to the best of my knowledge and belief. Kansas Water Well Contractor's License No. 759 This Water Well Record was completed on (mo-day-year) 4/26/2015 under the business name of RAZEK Environmental, LLC *Calvin Danton*