

WATER WELL RECORD Form WWC-5


Division of Water Resources App. No.

Well ID

Original Record Correction Change in Well Use

1 LOCATION OF WATER WELL: County: Sedgwick	Fraction SE 1/4 NW 1/4 NW 1/4	Section Number 35	Township Number T 27 S	Range Number R 1 E W
---	---	-----------------------------	----------------------------------	--------------------------------

2 WELL OWNER: Last Name: KDHE-BER Business: KDHE-BER Address: 1000 SW Jackson, Suite 410 Address: City: Topeka State: KS ZIP: 66612	First: _____ Street or Rural Address where well is located (if unknown, distance and direction from nearest town or intersection): If at owner's address, check here: <input type="checkbox"/> McDonald's 1630 South Hillside Street, Wichita, KS 67211
--	--

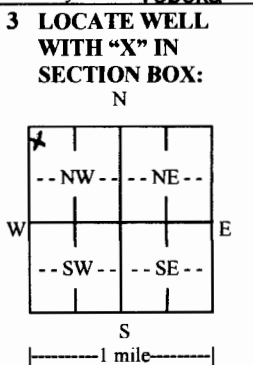

4 DEPTH OF COMPLETED WELL: **34** ft.

Depth(s) Groundwater Encountered: 1) ft.
 2) **N/A** ft. 3) **N/A** ft., or 4) Dry Well

WELL'S STATIC WATER LEVEL: ft.

below land surface, measured on (mo-day-yr).....
 above land surface, measured on (mo-day-yr).....

Pump test data: Well water was **N/A** ft.
 after **N/A** hours pumping **N/A** gpm
 Well water was **N/A** ft.
 after **N/A** hours pumping **N/A** gpm

Estimated Yield: **N/A** gpm
 Bore Hole Diameter: **8.25** in. to **34** ft. and
N/A in. to **N/A** ft.

5 Latitude: (decimal degrees)
Longitude: (decimal degrees)
 Horizontal Datum: WGS 84 NAD 83 NAD 27
 Source for Latitude/Longitude:
 GPS (unit make/model:)
 (WAAS enabled? Yes No)
 Land Survey Topographic Map
 Online Mapper:

6 Elevation: ft. Ground Level TOC
 Source: Land Survey GPS Topographic Map
 Other

7 WELL WATER TO BE USED AS:

1. Domestic: <input type="checkbox"/> Household <input type="checkbox"/> Lawn & Garden <input type="checkbox"/> Livestock 2. <input type="checkbox"/> Irrigation 3. <input type="checkbox"/> Feedlot 4. <input type="checkbox"/> Industrial	5. <input type="checkbox"/> Public Water Supply: well ID	10. <input type="checkbox"/> Oil Field Water Supply: lease
6. <input type="checkbox"/> Dewatering: how many wells?	7. <input type="checkbox"/> Aquifer Recharge: well ID	11. Test Hole: well ID
8. <input checked="" type="checkbox"/> Monitoring: well ID MW-47	9. Environmental Remediation: well ID	12. Geothermal: how many bores?
<input type="checkbox"/> Air Sparge <input type="checkbox"/> Soil Vapor Extraction <input type="checkbox"/> Recovery <input type="checkbox"/> Injection	13. <input type="checkbox"/> Other (specify):	a) Closed Loop <input type="checkbox"/> Horizontal <input type="checkbox"/> Vertical b) Open Loop <input type="checkbox"/> Surface Discharge <input type="checkbox"/> Inj. of Water

Was a chemical/bacteriological sample submitted to KDHE? Yes No If yes, date sample was submitted: **N/A**

Water well disinfected? Yes No

8 TYPE OF CASING USED: Steel PVC Other CASING JOINTS: Glued Clamped Welded Threaded

Casing diameter **2** in. to **1.9** ft., Diameter **N/A** in. to **N/A** ft., Diameter **N/A** in. to **N/A** ft.
 Casing height above land surface **0** in. Weight **N/A** lbs./ft. Wall thickness or gauge No. **Sch 40**

TYPE OF SCREEN OR PERFORATION MATERIAL:
 Steel Stainless Steel Fiberglass PVC Other (Specify)

Brass Galvanized Steel Concrete tile None used (open hole)

SCREEN OR PERFORATION OPENINGS ARE:
 Continuous Slot Mill Slot Gauze Wrapped Torch Cut Drilled Holes Other (Specify)

Louvered Shutter Key Punched Wire Wrapped Saw Cut None (Open Hole)

SCREEN-PERFORATED INTERVALS: From **1.9** ft. to **34** ft., From **N/A** ft. to **N/A** ft., From **N/A** ft. to **N/A** ft.
 GRAVEL PACK INTERVALS: From **1.7** ft. to **34** ft., From **N/A** ft. to **N/A** ft., From **N/A** ft. to **N/A** ft.

9 GROUT MATERIAL: Neat cement Cement grout Bentonite Other **Concrete 0 to 2-feet**

Grout Intervals: From **2** ft. to ft., From **N/A** ft. to **N/A** ft., From **N/A** ft. to **N/A** ft.

Nearest source of possible contamination:

<input type="checkbox"/> Septic Tank	<input type="checkbox"/> Lateral Lines	<input type="checkbox"/> Pit Privy	<input type="checkbox"/> Livestock Pens	<input type="checkbox"/> Insecticide Storage
<input type="checkbox"/> Sewer Lines	<input type="checkbox"/> Cess Pool	<input type="checkbox"/> Sewage Lagoon	<input checked="" type="checkbox"/> Fuel Storage	<input type="checkbox"/> Abandoned Water Well
<input type="checkbox"/> Watertight Sewer Lines	<input type="checkbox"/> Seepage Pit	<input type="checkbox"/> Feedyard	<input type="checkbox"/> Fertilizer Storage	<input type="checkbox"/> Oil Well/Gas Well
<input type="checkbox"/> Other (Specify)				

Direction from well? Distance from well? ft.

10 FROM	TO	LITHOLOGIC LOG	FROM	TO	LITHO. LOG (cont.) or PLUGGING INTERVALS
0	1	Grass, topsoil			grain, saturated
1	20	CLAY, reddish brown, silty moist to dry, very stiff some iron oxide nodules			
20	22.5	CLAY, brown, moist, silty medium stiff			
22.5	28	SAND, medium grain moist			
28	34	SAND, medium to very coarse			

11 CONTRACTOR'S OR LANDOWNER'S CERTIFICATION: This water well was constructed, reconstructed, or plugged under my jurisdiction and was completed on (mo-day-year) **4-1-15** and this record is true to the best of my knowledge and belief. Kansas Water Well Contractor's License No. **759** This Water Well Record was completed on (mo-day-year) **4/24/2015** under the business name of **RAZEK Environmental, LLC**