


NORTH AMIDON AVENUE

21ST STREET

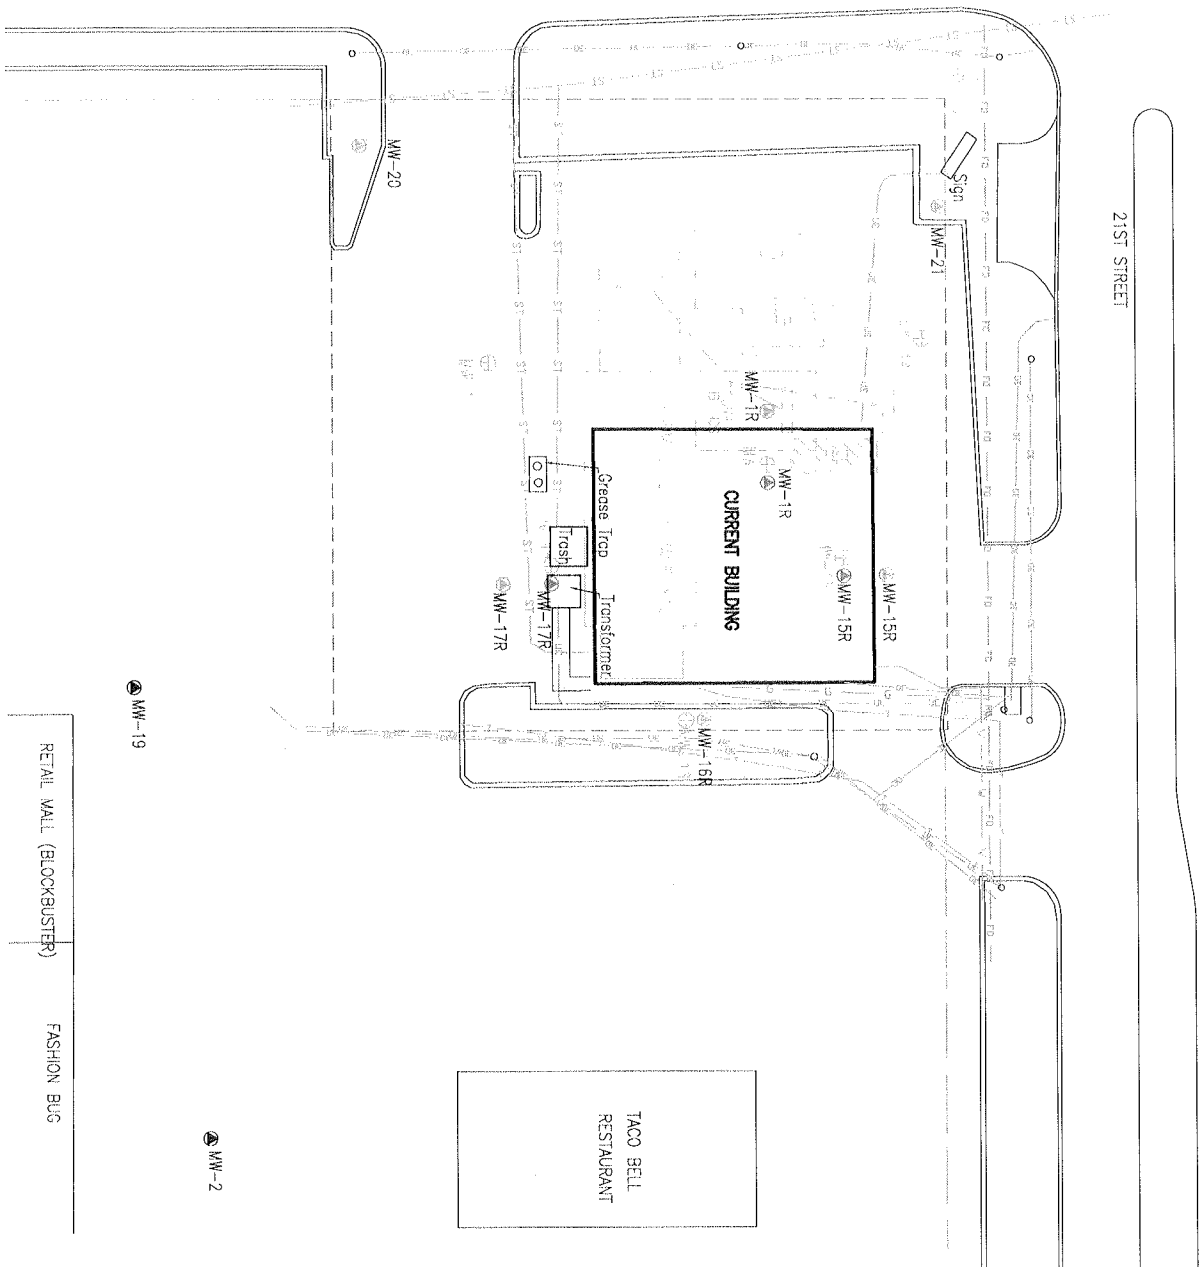

RETAIL MALL (BLOCKBUSTER)

FASHION BUC

1.0

Cardno
ATC
Shaping the Future

PROPOSED REPLACEMENT WELL LOCATIONS

FORMER COASTAL MART #9157
1925 WEST 21ST STREET NORTH
WICHITA, KANSAS

| | | | |
|---------------------------------|--------------------------------|--------------------------|----------------------------|
| PROJECT NUMBER: 1775000.2956 | DOCUMENT: MONITORING REPORT | DRAWN BY: MV 12/18/14 | CHECKED BY: JP 12/18/14 |
| FILE PATH: 2956-1.DWG | | | |

LEGEND

- ⊙ MODIFIED REPLACEMENT MONITORING WELL LOCATIONS
- ⊙ ORIGINAL REPLACEMENT MONITORING WELL LOCATIONS
- ⊙ MONITORING WELL
- ⊙ ABANDONED/DESTROYED MONITORING WELL
- ▨ LST REMOVED (CORROSION)
- ▨ LST REMOVED (NO CORROSION)
- SITE BOUNDARY
- PROPERTY BOUNDARIES
- NATURAL GAS
- STORM DRAIN / SEWER
- OVERHEAD ELECTRIC
- WATER
- FIBER OPTICS
- UNDERGROUND ELECTRIC
- TELEPHONE
- PROPERTY LINE