


NORTH AMIDON AVENUE

21ST STREET

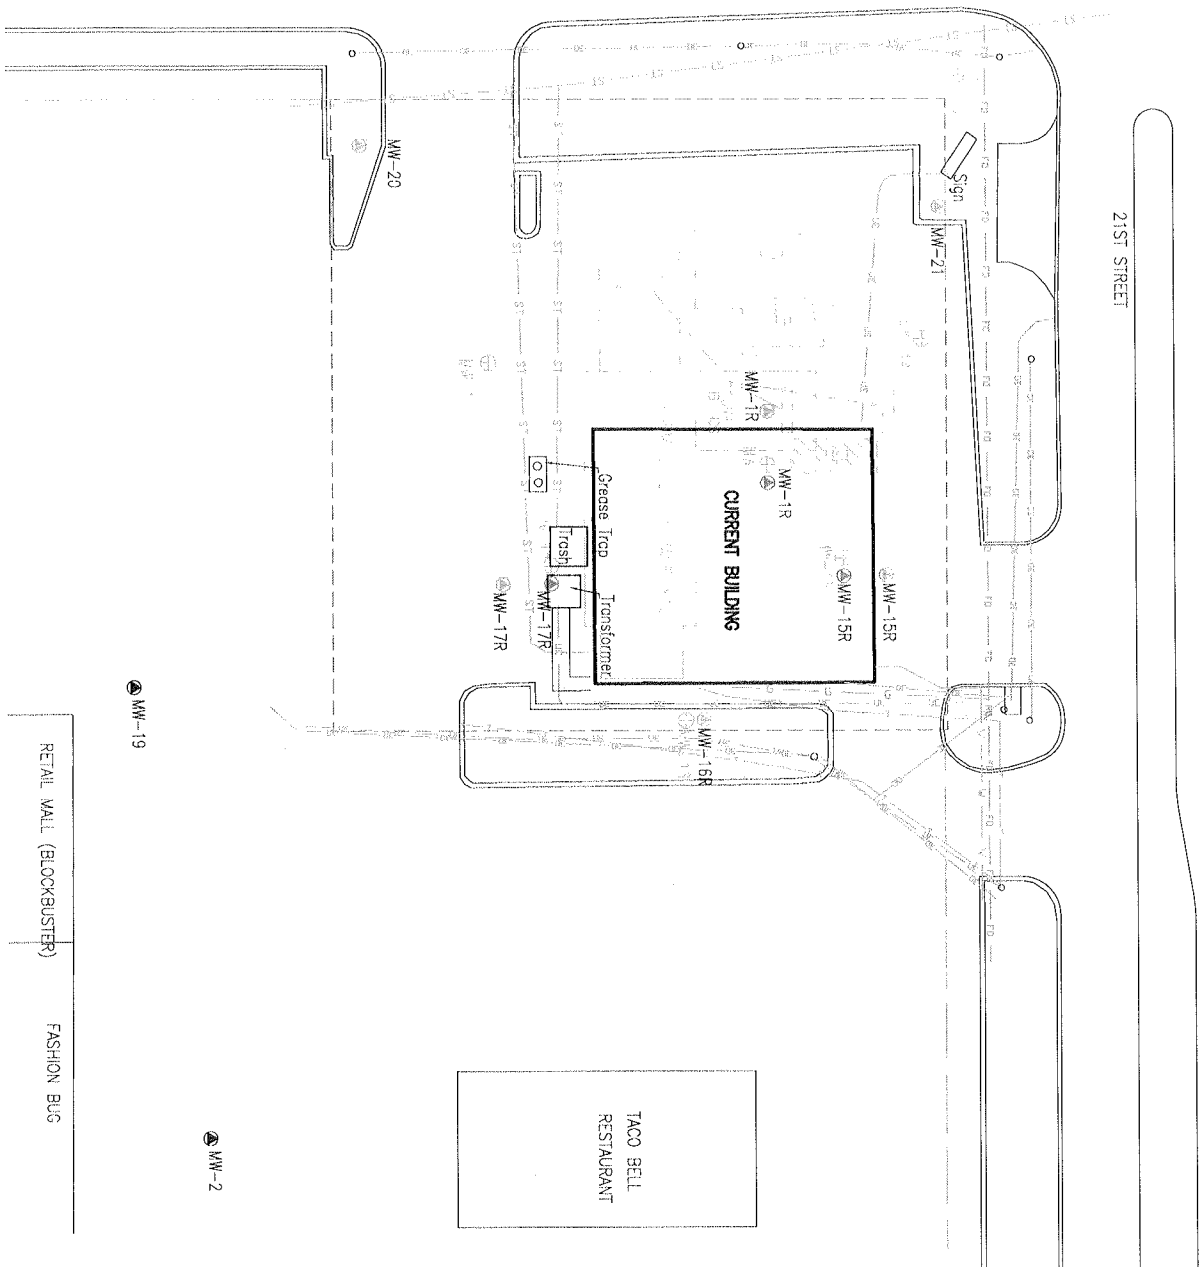

RETAIL MALL (BLOCKBUSTER)

FASHION BUC


1.0

Cardno
ATC
Shaping the Future

PROPOSED REPLACEMENT WELL LOCATIONS

FORMER COASTAL MART #9157
1925 WEST 21ST STREET NORTH
WICHITA, KANSAS

PROJECT NUMBER: 1775000.2956	DOCUMENT: MONITORING REPORT	DRAWN BY: MV 12/18/14	CHECKED BY: JP 12/18/14
FILE PATH: 2956-1.DWG			

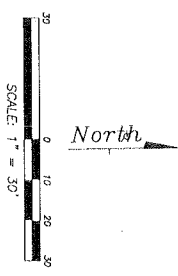

- LEGEND**
- ⊙ MODIFIED REPLACEMENT MONITORING WELL LOCATIONS
 - ⊙ ORIGINAL REPLACEMENT MONITORING WELL LOCATIONS
 - ⊙ MONITORING WELL
 - ⊙ ABANDONED/DESTROYED MONITORING WELL
 - ▨ LST REMOVED (CORROSION)
 - ▨ LST REMOVED (NO CORROSION)
 - SITE BOUNDARY
 - PROPERTY BOUNDARIES
 - NATURAL GAS
 - STORM DRAIN / SEWER
 - OVERHEAD ELECTRIC
 - WATER
 - FIBER OPTICS
 - UNDERGROUND ELECTRIC
 - TELEPHONE
 - PROPERTY LINE