# WATER WELL RECORD Form WWC-5

☒ Original Record ☐ Correction ☐ Change in Well Use

Division of Water Resources App. No. _____ Well ID _____

**1 LOCATION OF WATER WELL:** County: Sedgwick | Fraction: SE ¼ NW ¼ NW ¼ NE ¼ | Section Number: 28 | Township Number: T 27 S | Range Number: R 1 ☒ E ☐ W

**2 WELL OWNER:** Last Name: Walker First: _____
Business: _____
Address: 601 s Laura
Address: _____
City: Wichita State: KS ZIP: 67211

Street or Rural Address where well is located (if unknown, distance and direction from nearest town or intersection): If at owner's address, check here: ☐
601 s Laura

**3 LOCATE WELL WITH "X" IN SECTION BOX:**

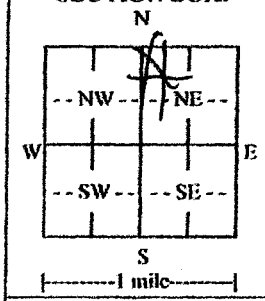


**4 DEPTH OF COMPLETED WELL:** 33 ft.
Depth(s) Groundwater Encountered: 1) 15 ft. 2) ..... ft. 3) ..... ft., or 4) ☐ Dry Well
WELL'S STATIC WATER LEVEL: 15
☒ below land surface, measured on (mo-day-yr) 7-10-15
☐ above land surface, measured on (mo-day-yr) .....
Pump test data: Well water was ..... ft. after ..... hours pumping ..... gpm
Well water was ..... ft. after ..... hours pumping ..... gpm
Estimated Yield: ..... gpm
Bore Hole Diameter: 7 in. to 15 ft. and ..... in. to ..... ft.

**5 Latitude:** ..... (decimal degrees)
**Longitude:** ..... (decimal degrees)
Datum: ☐ WGS 84 ☐ NAD 83 ☐ NAD 27
Source for Latitude/Longitude:
☐ GPS (unit make/model: .....
(WAAS enabled? ☐ Yes ☐ No)
☐ Land Survey ☐ Topographic Map
☐ Online Mapper: .....

**6 Elevation:** ..... ft. ☐ Ground Level ☐ TOC
Source: ☐ Land Survey ☐ GPS ☐ Topographic Map ☐ Other .....

**7 WELL WATER TO BE USED AS:**
1. Domestic: ☐ Household ☒ Lawn & Garden ☐ Livestock
2. ☐ Irrigation
3. ☐ Feedlot
4. ☐ Industrial
5. ☐ Public Water Supply: well ID .....
6. ☐ Dewatering: how many wells? .....
7. ☐ Aquifer Recharge: well ID .....
8. ☐ Monitoring: well ID .....
9. Environmental Remediation: well ID ..... ☐ Air Sparge ☐ Soil Vapor Extraction ☐ Recovery ☐ Injection
10. ☐ Oil Field Water Supply: lease .....
11. Test Hole: well ID ..... ☐ Cased ☐ Uncased ☐ Geotechnical
12. Geothermal: how many bores? ..... a) Closed Loop ☐ Horizontal ☐ Vertical b) Open Loop ☐ Surface Discharge ☐ Inj. of Water
13. ☐ Other (specify): .....

**Was a chemical/bacteriological sample submitted to KDHE?** ☐ Yes ☒ No If yes, date sample was submitted: .....
Water well disinfected? ☐ Yes ☒ No

**8 TYPE OF CASING USED:** ☐ Steel ☒ PVC ☐ Other ..... CASING JOINTS: ☒ Glued ☐ Clamped ☐ Welded ☐ Threaded
Casing diameter 5 in. to 23 ft., Diameter ..... in. to ..... ft., Diameter ..... in. to ..... ft.
Casing height above land surface 12 in. Weight ..... lbs./ft. Wall thickness or gauge No. 160

TYPE OF SCREEN OR PERFORATION MATERIAL:
☐ Steel ☐ Stainless Steel ☐ Fiberglass ☒ PVC ☐ Other (Specify) .....
☐ Brass ☐ Galvanized Steel ☐ Concrete tile ☐ None used (open hole)

SCREEN OR PERFORATION OPENINGS ARE:
☐ Continuous Slot ☒ Mill Slot ☐ Gauze Wrapped ☐ Torch Cut ☐ Drilled Holes ☐ Other (Specify) .....
☐ Louvered Shutter ☐ Key Punched ☐ Wire Wrapped ☐ Saw Cut ☐ None (Open Hole)

SCREEN-PERFORATED INTERVALS: From 23 ft. to 33 ft., From ..... ft. to ..... ft., From ..... ft. to ..... ft.
GRAVEL PACK ~~INTERVALS:~~ From none ft. to ..... ft., From ..... ft. to ..... ft., From ..... ft. to ..... ft.

**9 GROUT MATERIAL:** ☐ Neat cement ☐ Cement grout ☒ Bentonite ☐ Other .....
Grout Intervals: From 0 ft. to 15 ft., From ..... ft. to ..... ft., From ..... ft. to ..... ft.

**Nearest source of possible contamination:**
☐ Septic Tank ☐ Lateral Lines ☐ Pit Privy ☐ Livestock Pens ☐ Insecticide Storage
☐ Sewer Lines ☐ Cess Pool ☐ Sewage Lagoon ☐ Fuel Storage ☐ Abandoned Water Well
☒ Watertight Sewer Lines ☐ Seepage Pit ☐ Feedyard ☐ Fertilizer Storage ☐ Oil Well/Gas Well
☐ Other (Specify) .....
Direction from well? South Distance from well? 15 ft.

| 10 FROM | TO | LITHOLOGIC LOG | FROM | TO | LITHO. LOG (cont.) or PLUGGING INTERVALS |
|---|---|---|---|---|---|
| 0 | 3 | Top Soil | | | |
| 3 | 17 | Fine tan Sand | | | |
| 17 | 33 | Coarse tan Sand | | | |

Notes:

**11 CONTRACTOR'S OR LANDOWNER'S CERTIFICATION:** This water well was ☒ constructed, ☐ reconstructed, or ☐ plugged under my jurisdiction and was completed on (mo-day-year) 7-10-15 and this record is true to the best of my knowledge and belief. Kansas Water Well Contractor's License No. 472 This Water Well Record was completed on (mo-day-year) 7-10-15 under the business name of Bearden Pump & Well

INSTRUCTIONS: Send one copy to WATER WELL OWNER and retain one copy for your records. Submit fee of $5.00 for each constructed well along with one (white) copy to Kansas Department of Health and Environment, Bureau of Water, Geology Section, 1000 SW Jackson St., Suite 420, Topeka, Kansas 66612-1367. Telephone (785) 296-3565.

Visit us at http://www.kdheks.gov/waterwell/index.html