

WATER WELL RECORD

Form WWC-5

Division of Water Resources App. No.


Well ID

MW12

Original Record Correction Change in Well Use

1 LOCATION OF WATER WELL: County Sedgwick Fraction NW 1/4 NE 1/4 NE 1/4 NW 1/4 Section Number 16 Township Number T 27 S Range Number R 1 E W

2 WELL OWNER: Last Name: Business: KDHE-BER (Klepper Korner Store) Address: 1000 SW Jackson Blvd City Topeka State: KS ZIP: 66612 Street or Rural Address where well is located (if unknown, distance and direction from nearest town or intersection): 1401 N. Mosley, Wichita, KS 67214

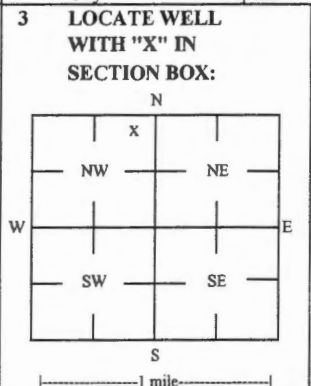

4 DEPTH OF COMPLETED WELL: 19.98 ft Depth(s) Groundwater Encountered: 1) 19.98 ft 2) 0 ft 3) 0 ft or 4) Dry Well WELL'S STATIC WATER LEVEL: 14.55 ft

5 Latitude: 37.70780 (decimal degrees) Longitude: 97.32841 (decimal degrees) Horizontal Datum: X WGS 84 NAD 83 NAD 27

6 Elevation: 1305.46 ft Ground Level TOC Source: X Land Survey GPS Topographic Map

7 WELL WATER TO BE USED AS: 1 Domestic: Household Lawn & Garden Livestock Irrigation Feedlot Industrial 5 Public Water Supply: well ID 6 Dewatering: how many wells? 7 Aquifer Recharge: well ID 8 Monitoring: well ID MW12 9 Environmental Remediation: well ID Air Sparge Soil Vapor Extractor Recovery Injection 10 Oil Field Water Supply: lease 11 Test Hole: well ID Cased Uncased Geotechnical 12 Geothermal: How many bores? a) Closed Loop Horizontal Vertical b) Open Loop Surface Discharge Inj. of Water Other (specify):

Was a chemical/bacteriological sample submitted to KDHE? Yes No X No If yes, date sample was submitted:

8 TYPE OF CASING USED: Steel PVC Other CASING JOINTS: Glued Clamped Welded Threaded Casing diameter 2 in. to 9.98 ft, Diameter in. to ft, Diameter in. to ft, Casing height above land surface 0.22 in. Weight lbs./ft. Well thickness or gauge No TYPE OF SCREEN OR PERFORATION MATERIAL: Steel Stainless Steel Fiberglass PVC Other (Specify) Brass Galvanized Steel Concrete tile None used (open hole) SCREEN OR PERFORATION OPENINGS ARE: Continuous Slot X Mill Slot Gauze Wrapped Torch Cut Drilled Holes Other (Specify) Louvered Shutter Key Punched Wire Wrapped Saw Cut None (Open Hole) SCREEN-PERFORATED INTERVALS: From 9.98 ft. to 19.98 ft, From ft. to ft, From ft. to ft, GRAVEL PACK INTERVALS: From 8 ft. to 20.5 ft, From ft. to ft, From ft. to ft,

9 GROUT MATERIAL: Neat cement Cement grout Bentonite Other Concrete: 0-0.5' Grout intervals: From 0.5 ft. to 8 ft, From ft. to ft, From ft. to ft,

Nearest source of possible contamination: Septic Tank Lateral Lines Pit Privy Livestock Pens Insecticide Storage Sewer Lines Cess Pool Sewage Lagoon Fuel Storage Abandoned Water Well Watertight Sewer Lines Seepage Pit Feedyard Fertilizer Storage Oil Well / Gas Well Other (Specify) Direction from well? NE Distance from well? ~180 ft

Table with columns: FROM, TO, LITHOLOGIC LOG, FROM, TO, LITHO. LOG (cont.) or PLUGGING INTERVALS. Rows: 0 to 0.4 Gravel, 0.4 to 6 Medium brown silty clay, 6 to 9.5 Tan brown silty clay, 9.5 to 20.5 Fine tan sand

Notes: KDHE ID: Klepper Korner Store; U2-087-01277

11 CONTRACTOR'S OR LANDOWNER'S CERTIFICATION: This water well was X constructed, reconstructed, or plugged under my jurisdiction and was completed on (mo-day-year) 2/2/16 and this record is true to the best of my knowledge and belief. Kansas Water Well Contractor's License No 757 This Water Well Record was completed on (mo-day-year) 3/21/16 under the business name of Larsen & Associates, Inc. Signature

Mail 1 white copy along with a fee of \$5.00 for each constructed well to: Kansas Department of Health and Environment, Bureau of Water, GWTS Section, 1000 SW Jackson St., Suite 420, Topeka, Kansas 66612-1367. Mail one to Water Well Owner and retain one for your records. Telephone 785-296-5524.

TRITERRA LAND SERVICES

P.O. Box 546
Clearwater, Kansas 67026
Cell (316) 648-3617
Fax (620) 584-4371
Email: triterrals@yahoo.com

SURVEYING OF REPLACEMENT AND ADDITIONAL MONITORING WELL
KLEPPER KORNER STORE
WICHITA, KANSAS

The site is located in the Section 9, Township 27 South, Range 1 East of the Sixth Principal Meridian, Sedgwick County, Kansas. The Southeast corner of Section 9 was assigned coordinates of 00.00 North and 00.00 West.

The top of casing of MW-2 was used for vertical control. A new control point was established as a chiseled 'X' on the SW corner of the base of the signal light on the southwest corner of the intersection.

The Latitude and Longitude were recorded from a GPS unit. The site is located on the 7.5' quad map titled "Wichita East".

| ID | NORTH | WEST | LATITUDE | LONGITUDE | ELEVATION |
|-------------------------------|---------|---------|----------|-----------|----------------------------|
| SE CORNER 9-27S-1E | 00.00 | 00.00 | | | |
| CP | -52.91 | 3037.18 | 37.70792 | 97.32784 | 1303.91 |
| MW-5RR(Sec 16) NW NE NE NW | -180.16 | 3033.15 | 37.70755 | 97.32788 | RIM 1304.29 TOC 1304.05 |
| MW-12(Sec 16) NW NE NE NW | -95.23 | 3200.84 | 37.70780 | 97.32841 | RIM 1305.68 TOC 1305.46 |

