

WATER WELL RECORD

Form WWC-5


Division of Water Resources App. No.

MW-2

1 LOCATION OF WATER WELL: County: Sedgwick Fraction SW 1/4 SW 1/4 SE 1/4 SE 1/4 Section Number 09 Township No. T 27 S Range Number R 01 [X]E []W

Street/Rural Address of Well Location: 1000 E. 13th Street N., Wichita, KS Global Positioning System (GPS) information: Latitude: 37.78678 Longitude: 97.325959

2 WATER WELL OWNER: Scott & Lindsay Hall RR#, Street Address, Box #: 1221 East Murdock City, State, ZIP Code : Wichita, KS 67214

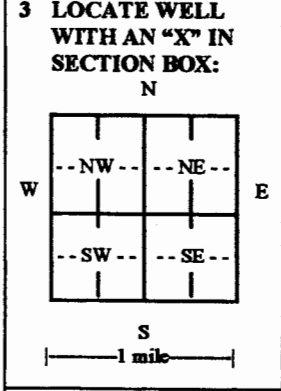

3 LOCATE WELL WITH AN 'X' IN SECTION BOX: 4 DEPTH OF COMPLETED WELL 25.0' ft. Depth(s) Groundwater Encountered (1)..... ft. (2)..... ft. (3)..... ft. WELL'S STATIC WATER LEVEL 13.62' ft. below land surface measured on mo/day/yr. 9/8/15

5 TYPE OF CASING USED: [] Steel [X] PVC [] Other CASING JOINTS: [] Glued [] Clamped [] Welded [X] Threaded Casing diameter 2.0" in. to 10.0' ft. Diameter..... in. to..... ft. Diameter..... in. to..... ft. Casing height above land surface. Flush in., Weight..... lbs./ft., Wall thickness or gauge No. Sch. 40

6 GROUT MATERIAL: [X] Neat cement [] Cement grout [X] Bentonite [] Other Grout Intervals: From 0 ft. to 1.0' ft., From 1.0' ft. to 8.0' ft., From..... ft. to..... ft. What is the nearest source of possible contamination: [] Septic tank [] Lateral lines [] Pit privy [] Livestock pens [] Insecticide storage [] Other (specify below)

Table with columns: FROM, TO, LITHOLOGIC LOG, FROM, TO, LITHO. LOG (cont.) or PLUGGING INTERVALS. Content: See Boring Log

7 CONTRACTOR'S OR LANDOWNER'S CERTIFICATION: This water well was [X] constructed, [] reconstructed, or [] plugged under my jurisdiction and was completed on (mo/day/year) 09/02/2015 and this record is true to the best of my knowledge and belief. Kansas Water Well Contractor's License No. 606 This Water Well Record was completed on (mo/day/year) 01/27/2016 under the business name of PSA Environmental Services, LLC by (signature)

INSTRUCTIONS: Use typewriter or ball point pen. PLEASE PRESS FIRMLY and PRINT clearly. Please fill in blanks and check the correct answers. Send three copies (white, blue, pink) to Kansas Department of Health and Environment, Bureau of Water, Geology Section, 1000 SW Jackson St., Suite 420, Topeka, Kansas 66612-1367. Telephone 785-296-5522. Send one copy to WATER WELL OWNER and retain one for your records. Include fee of \$5.00 for each constructed well. Visit us at http://www.kdheks.gov/waterwell/index.html

Boring Number:		MW-2		Page 1 of 1	
Location:		West of excavation		Date Started:	9/2/2015
Site Address:		1000 East 13th Street North		Date Completed:	9/2/2015
		Wichita, Kansas 67214		Depth to Groundwater:	13.62
Project Number:		15-138728.3		Field Technician:	CN
Drill Rig Type:		Geoprobe 6620		Partner Engineering and Science, Inc.	
Sampling Equipment:		Hollow Stem Auger		611 Industrial Way West	
Borehole Diameter:		8.25		Eatontown, NJ 07724	
Depth	Sample	PID	USCS	Description	Notes
1		0.0			
2			N/A	Fill material consisting of brown clay and gravel; slightly moist	No odor/staining
3		0.0			
4					
5		6.8			
6					
7					
8		4.3	CH	Black/gray clay; moist	Petroleum-like odor beginning at 5.0 feet bgs. Strong petroleum-like odor encountered at 10.0 feet bgs
9					
10		50.2			
11					
12				Gray fine sand; moist	Petroleum-like odor
13		25.4			
14					
15		5.7		Gray/brown medium sand; moist	Petroleum-like odor
16					
17		12.5			
18			SP		
19					
20		36.7			
21				Dark gray medium to coarse sand; saturated	Petroleum-like odor
22					
23		39.3			
24					
25					

Well screened from 10.0 to 25.0 feet bgs.