

WATER WELL RECORD

Form WWC-5

Division of Water Resources App. No.


Well ID

FMW4

Original Record Correction Change in Well Use

1 LOCATION OF WATER WELL: County Sedgwick Fraction SW 1/4 SW 1/4 NW 1/4 NW 1/4 Section Number 21 Township Number T 27 S Range Number R 1 E W

2 WELL OWNER: Last Name: First: Street or Rural Address where well is located (if unknown, distance and direction from nearest town or intersection): If at owner's address, check here: Business: Kansas Department of Health & Environment Address: 1000 SW Jackson, Suite 410 City: Topeka State: KS ZIP: 66612

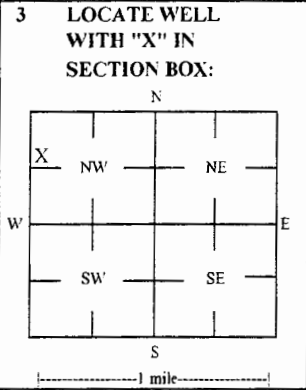

3 LOCATE WELL WITH "X" IN SECTION BOX: 4 DEPTH OF COMPLETED WELL: 19.87 ft Depth(s) Groundwater Encountered: 1) 19.87 ft 2) ft 3) ft or 4) Dry Well WELL'S STATIC WATER LEVEL: 18.01 ft

5 Latitude: 37.69014 (decimal degrees) Longitude: 97.33519 (decimal degrees) Horizontal Datum: X WGS 84 Source for Latitude/Longitude: X Land Survey

7 WELL WATER TO BE USED AS: 1 Domestic: 2 Irrigation: 3 Feedlot: 4 Industrial: 5 Public Water Supply: well ID: 6 Dewatering: how many wells?: 7 Aquifer Recharge: well ID: 8 Monitoring: well ID FMW4

Was a chemical/bacteriological sample submitted to KDHE? Yes No Water well disinfected? Yes No

8 TYPE OF CASING USED: Steel PVC Other CASING JOINTS: Glued Clamped Welded Threaded Casing diameter 2 in. to 9.87 ft. Diameter in. to ft. Casing height above land surface -0.35 in. Weight lbs./ft. Well thickness or gauge No

9 GROUT MATERIAL: Neat cement Cement grout Bentonite Other Concrete: 0-0.5' Grout intervals: From 0.5 ft. to 8 ft. From ft. to ft. From ft. to ft.

Nearest source of possible contamination: Septic Tank Lateral Lines Pit Privy Livestock Pens Insecticide Storage Sewer Lines Cess Pool Sewage Lagoon Fuel Storage Abandoned Water Well Watertight Sewer Lines Seepage Pit Feedyard Fertilizer Storage Oil Well / Gas Well

10 FROM TO LITHOLOGIC LOG FROM TO LITHO. LOG (cont.) or PLUGGING INTERVALS

Notes: KDHE ID: Former Filling Station: U2-087-14768

11 CONTRACTOR'S OR LANDOWNER'S CERTIFICATION: This water well was constructed, reconstructed, or plugged under my jurisdiction and was completed on (mo-day-year) 5/13/16 and this record is true to the best of my knowledge and belief.

# TRITERRA

## LAND SERVICES

P.O. Box 546  
 Clearwater, Kansas 67026  
 Cell (316) 648-3617 Fax (620) 584-4371  
 E-mail: triterrals@yahoo.com

**SURVEYING OF MONITORING WELLS  
 FORMER FILLING STATION  
 SE CORNER OF EAST 2<sup>ND</sup> & N. BROADWAY  
 WICHITA, KANSAS**

The above site is located in Section 21, Township 27 South, Range 1 East of the Sixth Principal Meridian, Sedgwick County, Kansas. The Southeast corner of Section 21 was assigned coordinates of 00.00 North and 00.00 West.

The top of casing elevations from an adjacent site, Kiser Parking Garage, were used for vertical control. A control point was established as a chiseled 'X' in the sidewalk, west of a KG & E manhole at the northeast corner of the property.

The Latitude and Longitude were recorded from a GPS unit. The site is located on the 7.5' quad map titled "Wichita East".

ID	NORTH	WEST	LATITUDE	LONGITUDE	ELEVATION
SE CORNER 21-27S-1E	00.00	00.00			
Control Point	3962.16	5127.35	37.68970	97.33501	1298.88
FMW-1 NW NW SW NW	3894.77	5261.85	37.68950	97.33544	RIM 1298.33 FOC 1298.10
FMW-2 NW NW SW NW	3956.30	5165.02	37.68969	97.33511	RIM 1298.98 TOC 1298.63
FMW-3 NW NW SW NW	3938.99	5097.50	37.68962	97.33492	RIM 1299.60 TOC 1299.08
FMW-4 SW SW NW NW	4118.28	5176.67	37.69014	97.33519	RIM 1301.05 TOC 1300.70
FMW-5 NW NW SW NW	3890.95	5071.34	37.68950	97.33482	RIM 1300.85 TOC 1300.48
FMW-6 NW NW SW NW	3797.22	5049.50	37.68924	97.33472	RIM 1300.41 TOC 1300.04
FMW-7 NE NE SE NE Sec 20-27S-1E	3947.29	5513.88	37.68964	97.33632	RIM 1298.79 TOC 1298.46

