WATER WELL PLUGGING RECORD **Form WWC-5P** **KSA 82a-1212** **ID NO.** **MW5**

1 LOCATION OF WATER WELL: County: Sedgwick	Fraction	Section Number	Township Number	Range Number
	SW ¼ SW ¼ SW ¼ SW ¼	34	T 27 S	1 [X] E [ ] W

Street/Rural Address of Well Location; if unknown, distance & direction from nearest town or intersection: If at owner's address, check here [ ]

1708 E. Pawnee, Wichita KS

Global Positioning Systems (GPS) information:
Latitude: NA (in decimal degrees)
Longitude: NA (in decimal degrees)
Elevation: NA
Horizontal Datum [ ] WGS84, [ ] NAD83, [ ] NAD27
Collection Method:
[ ] GPS unit (Make/model:)
[ ] Digital Map/Photo, [ ] Topographic Map [ ] Land Survey
Est. Accuracy: [ ] <3 m, [ ] 3-5 m, [ ] 5-15 m, [ ] >15 m

2 WATER WELL OWNER: Richard Hammer
RR#, St. Address, Box #: 15 Northmore St.,
City, State ZIP Code: Daglish, West Australia 6008

3 MARK WELL'S LOCATION WITH AN "X" IN SECTION BOX:

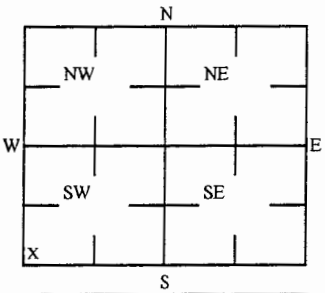

4 DEPTH OF WELL 22.09 **ft.** **MW5**

WELL'S STATIC WATER LEVEL _____ ft

WELL WAS USED AS:

[ ] Domestic [ ] Public Water Supply [ ] Dewatering
[ ] Irrigation [ ] Oil Field Water Supply [X] Monitoring
[ ] Feedlot [ ] Domestic (Lawn & Garden) [ ] Injetion Well
[ ] Industrial [ ] Air Conditioning [ ] Other _____

Was a chemical/bacteriological sample submitted to Department? Yes [ ] No [X]

5 TYPE OF BLANK CASING USED:

[ ] Steel [ ] RMP (SR) [ ] Wrought [ ] Fiberglass [ ] Other (Specific below)
[X] PVC [ ] ABS [ ] Asbestos-Cement [ ] Concrete Tile

Blank casing diameter 2 in. Was casing pulled? Yes [X] No [ ] If yes, how much 3'
Casing heigh above or below land surface NA in.

6 GROUT PLUG MATERIAL: [ ] Neat cement [ ] Cement grout [X] Bentonite [X] Other Soil: 0-3'

Grout Plug Intervals: From 3 ft to 22.09 ft, From _____ ft to _____ ft, From _____ ft to _____ ft,

What is the nearest source of possible contamination:

[ ] Septic tank [ ] Seepage pit [ ] Fuel storage [ ] Other (specify below)
[ ] Sewer lines [ ] Pit privy [ ] Fertilizer storage
[ ] Watertight sewer lines [ ] Sewage lagoon [ ] Insecticide storage
[ ] Lateral lines [ ] Feed yard [ ] Abandoned water well Direction from well? _____
[ ] Cess pool [ ] Livestock pens [ ] Oil well/Gas well How many feet? _____

FROM	TO	PLUGGING MATERIALS	FROM	TO	PLUGGING MATERIALS
0	3	Soil			
3	22.09	Bentonite			
			KDHE ID:	Former Service Station, U2-087-13057	

7 CONTRACTOR'S OR LANDOWNER'S CERTIFICATION: This water well was plugged under my jurisdiction and was completed on (mo/day/year) 3/14/2016 and this record is true to the best of my knowledge and belief. Kansas Water Contractor's License No. 757 . This Water Well Record was completed on (mo/day/year) 4/4/2016 under the business name of Larsen & Associates, Inc. By (signature) _____

Send one white copy to Kansas Department of Health & Environment, Geology Section, 1000 SW Jackson Street, Ste. 420, Topeka, KS 66612-1367. Send one copy to WATER WELL OWNER and retain one for your records.
Visit us at http://www.kdheks.gov/waterwell/index.html Telephone 785-296-5524.