

WATER WELL RECORD

Form WWC-5

Division of Water Resources App. No.


Well ID

MW9

Original Record Correction Change in Well Ust

1 LOCATION OF WATER WELL: County Sedgwick Fraction SW 1/4 NE 1/4 NW 1/4 SE 1/4 Section Number 21 Township Number T 27 S Range Number R 1 E

2 WELL OWNER: Last Name: Business: KDHE Address: 1000 SW Jackson Blvd City Topeka State: KS ZIP: 66612 Street or Rural Address where well is located (if unknown, distance and direction from nearest town or intersection): ~70' S of 133 Pattie, Wichita KS

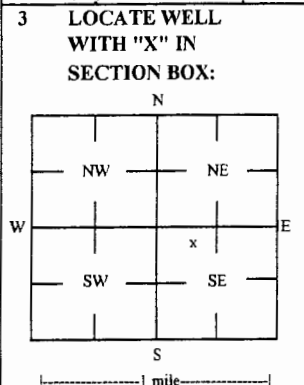

4 DEPTH OF COMPLETED WELL: 18.89 ft Depth(s) Groundwater Encountered: 1) 18.89 ft 2) 0 ft 3) 0 ft or 4) Dry Well WELL'S STATIC WATER LEVEL: 11.98 ft below land surface, measured on (mo-day-yr) 9/1/2016

5 Latitude: 37.68469 (decimal degrees) Longitude: 97.32305 (decimal degrees) Horizontal Datum: WGS 84 Source for Latitude/Longitude: Land Survey

6 Elevation: 1293.99 ft Ground Level TOC Source: Land Survey GPS Topographic Map

7 WELL WATER TO BE USED AS: 1 Domestic: 2 Irrigation: 3 Feedlot: 4 Industrial: 5 Public Water Supply: well ID 6 Dewatering: how many wells? 7 Aquifer Recharge: well ID 8 Monitoring: well ID MW9 9 Environmental Remediation: well ID 10 Oil Field Water Supply: lease 11 Test Hole: well ID 12 Geothermal: How many bores?

Was a chemical/bacteriological sample submitted to KDHE? Yes No If yes, date sample was submitted: Water well disinfected? Yes No

8 TYPE OF CASING USED: Steel PVC Other CASING JOINTS: Glued Clamped Welded Threaded Casing diameter 2 in. to 8.89 ft Diameter 8.89 in. to 18.89 ft Casing height above land surface -0.37 in. Weight lbs./ft. Well thickness or gauge No TYPE OF SCREEN OR PERFORATION MATERIAL: Steel Stainless Steel Fiberglass PVC Other (Specify) SCREEN OR PERFORATION OPENINGS ARE: Continuous Slot Mill Slot Gauze Wrapped Torch Cut Drilled Holes Other (Specify) Louvered Shutter Key Punched Wire Wrapped Saw Cut None (Open Hole) SCREEN-PERFORATED INTERVALS: From 8.89 ft. to 18.89 ft. GRAVEL PACK INTERVALS: From 7.5 ft. to 19.5 ft.

9 GROUT MATERIAL: Neat cement Cement grout Bentonite Other Concrete: 0-0.5' Grout intervals: From 0.5 ft. to 7.5 ft.

Nearest source of possible contamination: Septic Tank Lateral Lines Pit Privy Livestock Pens Insecticide Storage Sewer Lines Cess Pool Sewage Lagoon Fuel Storage Abandoned Water Well Watertight Sewer Lines Seepage Pit Feedyard Fertilizer Storage Oil Well / Gas Well Other (Specify) Direction from well? SW Distance from well? ~65 ft

Table with columns: FROM, TO, LITHOLOGIC LOG, FROM, TO, LITHO. LOG (cont.) or PLUGGING INTERVALS. Rows: 0-0.5 Concrete, 0.5-7 Silty clay, 7-10.5 Silty sand w/ clay, 10.5-19.5 Fine sand. Notes: KDHE ID: Parry & Sons; U2-087-00937

11 CONTRACTOR'S OR LANDOWNER'S CERTIFICATION: This water well was constructed, reconstructed or plugged under my jurisdiction and was completed on (mo-day-year) 8/31/16 and this record is true to the best of my knowledge and belief. Kansas Water Well Contractor's License No 757 This Water Well Record was completed on (mo-day-year) 10/18/16 under the business name of Larsen & Associates, Inc. Signature

# TRITERRA

## LAND SERVICES

P.O. Box 546  
Clearwater, Kansas 67026  
Office (620) 584-2313 Cell (316) 648-3617  
Fax (620) 584-4371  
E-mail: triterrals@yahoo.com

SURVEYING FOR ADDITIONAL MONITORING WELLS  
PARRY & SONS  
WICHITA, KANSAS

The above site is in Section 21, Township 27 South, Range 1 East of the Sixth Principal Meridian, Sedgwick County, Kansas. The Southeast corner of Section 21 was assigned coordinates of 00.00 North and 00.00 West.

The vertical control used for the survey were the previously established top of casing elevations of wells on site. A control point was established as a chiseled "X" on the top of curb directly east of MW-5.

The Latitude and Longitude were scaled from a 7.5' quad map titled "Wichita East".

ID	NORTH	WEST	LATITUDE	LONGITUDE	ELEVATION
SE CORNER 21-27S-1E	00.00	00.00			
Control Point	2130.93	1522.22	37.68472	97.32250	1292.94
MW-8 SE NE NW SE	2290.36	1531.01	37.68520	97.32252	RIM 1293.84 TOC 1293.45
MW-9 SW NE NW SE	2114.77	1676.92	37.68469	97.32305	RIM 1294.36 TOC 1293.99

