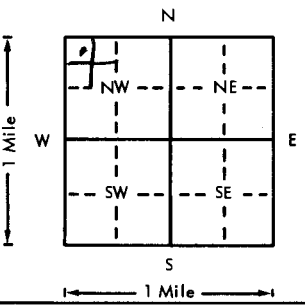


USE TYPEWRITER OR BALL
POINT PEN-PRESS FIRMLY,
PRINT CLEARLY.

WATER WELL RECORD
KSA 82a-1201-1215

Kansas Department of Health and
Environment-Division of Environment
(Water well Contractors)
Topeka, Kansas 66620

1. Location of well:		County Sedgwick	Fraction SE 1/4 NW 1/4 NW 1/4	Section number 18	Township number T 27 S R 1 E	Range number EDW
2. Distance and direction from nearest town or city: Street address of well location if in city: 1316 Arrowhead				3. Owner of well: Vincent Moore R.R. or street: 1316 N. Arrowhead City, state, zip code: Wichita KS 67203		
4. Locate with "X" in section below: 				Sketch map: 6. Bore hole dia. 9 in. Completion date 5-30-78 Well depth 27 ft. 7. <input type="checkbox"/> Cable tool <input type="checkbox"/> Rotary <input type="checkbox"/> Driven <input type="checkbox"/> Dug <input type="checkbox"/> Hollow rod <input type="checkbox"/> Jetted <input checked="" type="checkbox"/> Bored <input type="checkbox"/> Reverse rotary 8. Use: <input type="checkbox"/> Domestic <input type="checkbox"/> Public supply <input type="checkbox"/> Industry <input checked="" type="checkbox"/> Lawn <input type="checkbox"/> Air conditioning <input type="checkbox"/> Stock <input type="checkbox"/> Oil field water <input type="checkbox"/> Other 9. Casing: Material RMP Height: Above or below Threaded <input type="checkbox"/> Welded 610 Surface 12 in. RMP 1 PVC 0 Weight <input type="checkbox"/> lbs./ft. Dia. 6 in. to 0 ft. depth Wall Thickness: inches or Dia. 6 in. to 27 ft. depth gage No. 120		
5. Type and color of material				From	To	
LT. Tan med. Sand				0	10	10. Screen: Manufacturer's name Sunbwer Type RMP Dia. 6" Slot/gauze 3/16 Length 5 ft Set between 22 ft. and 27 ft. Gravel pack? 16 Size range of material
LT Brown med Course Gravel				10	27	11. Static water level: 10 ft. below land surface Date 5-30-78 12. Pumping level below land surfaces: ft. after hrs. pumping g.p.m. ft. after hrs. pumping g.p.m. Estimated maximum yield 60 g.p.m. 13. Water sample submitted: 12 mo./day/yr. Yes <input checked="" type="checkbox"/> No <input type="checkbox"/> Date 14. Well head completion: 12 inches above grade Pitless adapter <input type="checkbox"/> Neat cement <input type="checkbox"/> Bentonite <input checked="" type="checkbox"/> Concrete Depth: From 0 ft. to 10 ft. 15. Well grouted? yes With: <input type="checkbox"/> Neat cement <input type="checkbox"/> Bentonite <input checked="" type="checkbox"/> Concrete Depth: From 0 ft. to 10 ft. 16. Nearest source of possible contamination: SI ft. 10 Direction SE Type Sewer Well disinfected upon completion? Yes <input checked="" type="checkbox"/> No <input type="checkbox"/> 17. Pump: <input checked="" type="checkbox"/> Not installed Manufacturer's name Model number HP Volts Length of drop pipe ft. capacity g.p.m. Type: <input type="checkbox"/> Submersible <input type="checkbox"/> Turbine <input type="checkbox"/> Jet <input type="checkbox"/> Reciprocating <input type="checkbox"/> Centrifugal <input type="checkbox"/> Other
(Use a second sheet if needed)						
18. Elevation: Topography: <input type="checkbox"/> Hill <input type="checkbox"/> Slope <input checked="" type="checkbox"/> Upland <input type="checkbox"/> Valley		19. Remarks: 6" Cased well replaced old Sand Point well in Basement		20. Water well contractor's certification: This well was drilled under my jurisdiction and this report is true to the best of my knowledge and belief. Pratheroe Pump & Well 295 Business name 827 W 27 St Wichita License No. Address 827 W 27 St Wichita Date 5-30-78 Signed [Signature] Authorized representative		

Forward the white, blue and pink copies to the Department of Health and Environment

Form WWC-5