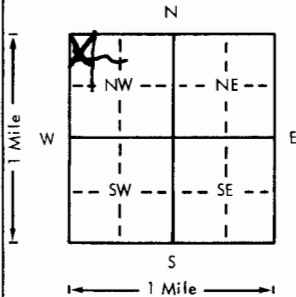
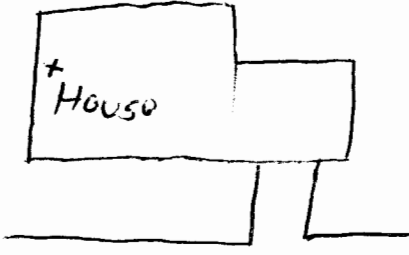


USE TYPEWRITER OR BALL  
POINT PEN-PRESS FIRMLY,  
PRINT CLEARLY.

WATER WELL RECORD  
KSA 82a-1201-1215

Kansas Department of Health and  
Environment-Division of Environment  
(Water well Contractors)  
Topeka, Kansas 66620

1. Location of well:		County <u>Sedgwick</u>	Fraction <u>NW 1/4 NW 1/4 NW 1/4</u>	Section number <u>19</u>	Township number <u>T 27 S</u>	Range number <u>R 1 E</u>	E/W <u>E</u>
2. Distance and direction from nearest town or city: Street address of well location if in city: <u>2440 Vermont</u>				3. Owner of well: <u>EDWIN KNOFFLOCK</u> R.R. or street: <u>2440 Vermont</u> City, state, zip code: <u>WICHITA, KS</u>			
4. Locate with "X" in section below:		Sketch map:		6. Bore hole dia. <u>11</u> in. Completion date <u>3-22-78</u> Well depth <u>20</u> ft.			
				7. <input type="checkbox"/> Cable tool <input type="checkbox"/> Rotary <input type="checkbox"/> Driven <input type="checkbox"/> Dug <input type="checkbox"/> Hollow rod <input checked="" type="checkbox"/> Jetted <input type="checkbox"/> Bored <input type="checkbox"/> Reverse rotary			
5. Type and color of material		From		To		8. Use: <input checked="" type="checkbox"/> Domestic <input type="checkbox"/> Public supply <input type="checkbox"/> Industry <input type="checkbox"/> Irrigation <input type="checkbox"/> Air conditioning <input type="checkbox"/> Stock <input type="checkbox"/> Low <input type="checkbox"/> Oil field water <input type="checkbox"/> Other	
<u>CLAY &amp; TOPSOIL</u>		<u>0</u>		<u>10</u>		9. Casing: Material <u>PVC</u> Height: Above or below Threaded <input type="checkbox"/> Welded <input type="checkbox"/> Surface <u>12</u> in. RMP <input type="checkbox"/> PVC <input checked="" type="checkbox"/> Weight <u>2750</u> lbs./ft. Dia. <u>5</u> in. to <u>30</u> ft. depth Wall Thickness: inches or Dia. <u>5</u> in. to <u>30</u> ft. depth gage No. <u>1250</u>	
<u>CLAY mixed with large gravel</u>		<u>10</u>		<u>14</u>		10. Screen: Manufacturer's name <u>MODERN</u> Type <u>PVC</u> Dia. <u>5"</u> Slot/gauze <u>.025</u> Length <u>5'</u> Set between <u>15</u> ft. and <u>20</u> ft. ft. and ft. Gravel pack? <u>NO</u> Size range of material	
<u>GRAVEL</u>		<u>15</u>		<u>20</u>		11. Static water level: _____ ma./day/yr. <u>15</u> ft. below land surface Date <u>3-22-78</u>	
						12. Pumping level below land surfaces: <u>16</u> ft. after <u>1</u> hrs. pumping <u>22</u> g.p.m. ft. after _____ hrs. pumping _____ g.p.m. Estimated maximum yield <u>45+</u> g.p.m.	
						13. Water sample submitted: _____ mo./day/yr. <input type="checkbox"/> Yes <input checked="" type="checkbox"/> No Date _____	
						14. Well head completion: <u>12</u> <input type="checkbox"/> Pitless adapter <input checked="" type="checkbox"/> _____ Inches above grade	
						15. Well grouted? <u>YES</u> With: <input checked="" type="checkbox"/> Neat cement <input type="checkbox"/> Bentonite <input type="checkbox"/> Concrete Depth: From <u>0</u> ft. to <u>16</u> ft.	
						16. Nearest source of possible contamination: ft. <u>90</u> Direction <u>E</u> Type <u>SEWAGE</u> Well disinfected upon completion? <input checked="" type="checkbox"/> Yes <input type="checkbox"/> No	
						17. Pump: _____ Not installed Manufacturer's name <u>DEMPSTER</u> Model number <u>2PM50</u> HP <u>1/2</u> Volts <u>110</u> Length of drop pipe <u>20</u> ft. capacity <u>12</u> g.p.m. Type: <input checked="" type="checkbox"/> Submersible <input type="checkbox"/> Turbine <input checked="" type="checkbox"/> Jet <input type="checkbox"/> Reciprocating <input type="checkbox"/> Centrifugal <input type="checkbox"/> Other	
18. Elevation:		19. Remarks:		20. Water well contractor's certification: This well was drilled under my jurisdiction and this report is true to the best of my knowledge and belief. <u>2157 E. Hattie</u> <u>129</u> Business name _____ License No. _____ Address <u>512 W. 2157</u> Signed <u>X. Harris</u> Date <u>3-22-78</u> Authorized representative			

Forward the white, blue and pink copies to the Department of Health and Environment

Form WWC-5