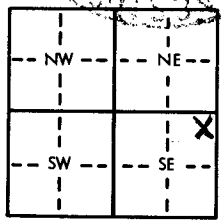
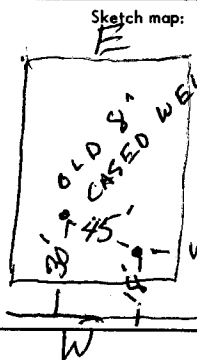


USE TYPEWRITER OR BALL
POINT PEN-PRESS FIRMLY,
PRINT CLEARLY.

WATER WELL RECORD
KSA 82a-1201-1215

Kansas Department of Health and
Environment-Division of Environment
(Water well Contractors)
Topeka, Kansas 66620

1. Location of well: <u>SEDEWICK</u>		Fraction <u>NE 1/4 NE 1/4 SE 1/4</u>		Section number <u>19</u>		Township number <u>T 27</u>		Range number <u>S R 1 E</u>	
2. Distance and direction from nearest town or city: Street address of well location if in city: <u>WILHITA, 115 SO. SENECA</u>				3. Owner of well: <u>CULBERTSON MORTUARY</u> R.R. or street: <u>115 SO. SENECA</u> City, state, zip code: <u>WILHITA KANS. - 67213</u>					
4. Locate with "X" in section below: 				Sketch map: 		6. Bore hole dia. <u>5</u> in. Completion date <u>12-3-75</u> Well depth <u>39</u> ft.			
5. Type and color of material				From		To		7. Cable tool ☐ Rotary ☒ Driven ☐ Dug ☐ Hollow rod ☐ Jetted ☒ Bored ☐ Reverse rotary	
FILL SAND				0		1		8. Use: ☐ Domestic ☐ Public supply ☐ Industry ☐ Irrigation ☐ Air conditioning ☐ Stock ☐ Lawn ☐ Oil field water ☒ Other	
BLACK SANDY LOAM				1		3		9. Casing: Material <u>1.25</u> Height: <u>Above</u> or below Threading <u>X</u> Welded ☐ Surface <u>1.25</u> in. Rope <u>DRIVE PIPE</u> Weight <u>2.27</u> lbs./ft. Dia. <u>1.25</u> in. to <u>35</u> ft. depth Wall Thickness: <u>inches</u> or Dia. <u>in.</u> to <u>ft.</u> depth gage No. <u>140</u>	
SANDY CLAY - YELLOW				3		5		10. Screen: Manufacturer's name <u>CLAYTON</u> <u>MARK</u> Type <u>BRASS</u> Dia. <u>1.25</u> Slot/gauge <u>0.060</u> Length <u>4</u> Set between <u>35</u> ft. and <u>39</u> ft. Gravel pack? <u>NO</u> Size range of material	
BLACK CLAY SANDY BLACK				5		6		11. Static water level: <u>18</u> ft. below land surface Date <u>12-3-75</u>	
CLAY BROWN				6		7		12. Pumping level below land surfaces: <u>NA</u> ft. after <u>NA</u> hrs. pumping g.p.m. <u>NA</u> ft. after <u>NA</u> hrs. pumping g.p.m. Estimated maximum yield <u>30</u> g.p.m.	
CLAY SANDY BROWN				7		9		13. Water sample submitted: <u>NA</u> mo./day/yr.	
SAND FINE YELLOW				9		10		14. Well head completion: ☐ Pitless adapter <u>12</u> inches above grade	
DROVE 1.25 GALV PIPE + POINT								15. Well grouted? <u>YES</u> With: <u>Neat cement</u> ☒ Bentonite ☒ Concrete Depth: From <u>0</u> ft. to <u>10</u> ft.	
TO								16. Nearest source of possible contamination: <u>18</u> Direction <u>WEST</u> Type <u>CITY SEWER</u> Well disinfected upon completion? ☐ Yes ☒ No	
NOTE - PLUGGED OLD 8"								17. Pump: <u>Not installed</u> Manufacturer's name <u>BURK'S</u> Model number <u>NA</u> HP <u>1</u> Volts <u>115</u> Length of drop pipe <u>39</u> ft. capacity <u>19</u> g.p.m. Type: <u>OWNER'S OLD PUMP</u> ☒ Submersible ☐ Turbine ☒ Jet ☐ Reciprocating ☐ Centrifugal ☐ Other	
GALV. CASED WELL AT THIS								20. Water well contractor's certification: This well was drilled under my jurisdiction and this report is true to the best of my knowledge and belief. <u>BEARDEN PUMP & WELL</u> <u>104</u> Business name <u>BEARDEN PUMP & WELL</u> License No. <u>104</u> Address <u>312 MENOR WILHITA KS</u> Signed <u>Ch. W. Bearden</u> Date <u>12-29</u> Authorized representative	
LOCATION - CUT CASING OFF									
AT CONCRETE FLOOR LEVEL									
FILLED WELL WITH SAND TO									
3 FT. FROM FLOOR - THEN FILLED									
TO FLUSH WITH CONCRETE									
18. Elevation: <u>1300 FT.</u>		19. Remarks:							
Topography: ☐ Hill ☐ Slope ☐ Upland ☒ Valley									

WATER
FALL
IN
CHAPEL
REF.
OUR
PHONE
VISIT
RECORD
ING
SAME
AND
SEWER
DISTANCE
FROM
WELL
IN
2
10
19
NE
NE
SE
1/4
1/4
1/4
1/4

Forward the white, blue and pink copies to the Department of Health and Environment

Form WWC-5