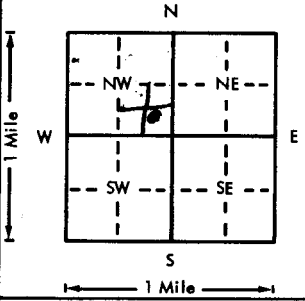


USE TYPEWRITER OR BALL
POINT PEN-PRESS FIRMLY,
PRINT CLEARLY.

WATER WELL RECORD
KSA 82a-1201-1215

Kansas Department of Health and
Environment-Division of Environment
(Water well Contractors)
Topeka, Kansas 66620

1. Location of well: County <u>Sedgwick</u> Fraction <u>SW NW SE NW</u> Section number <u>28</u> Township number <u>27</u> Range number <u>2</u> <u>E/V</u>	
2. Distance and direction from nearest town or city: Street address of well location if in city: <u>1023 ST. Fe</u>	
3. Owner of well: <u>Hemco Pipe & Htg</u> R.R. or street: <u>1139 ST Fe</u> City, state, zip code: <u>Wichita KS 67211</u>	
4. Locate with "X" in section below: Sketch map: 	
5. Type and color of material	
6. Bore hole dia. <u>10</u> in. Completion date <u>7-6-76</u> Well depth <u>32</u> ft.	
7. Cable tool <input type="checkbox"/> Rotary <input type="checkbox"/> Driven <input type="checkbox"/> Dug <input type="checkbox"/> Hollow rod <input type="checkbox"/> Jetted <input checked="" type="checkbox"/> Bored <input type="checkbox"/> Reverse rotary	
8. Use: Domestic <input type="checkbox"/> Public supply <input checked="" type="checkbox"/> Industry <input type="checkbox"/> Irrigation <input type="checkbox"/> Air conditioning <input type="checkbox"/> Stock <input type="checkbox"/> Lawn <input type="checkbox"/> Oil field water <input type="checkbox"/> Other	
9. Casing: Material <u>RMP</u> Height: Above or below <u>92</u> in. Threaded <input type="checkbox"/> Welded <input checked="" type="checkbox"/> Surface <u>92</u> in. RMP <input checked="" type="checkbox"/> PVC <u>92</u> Weight <u>132</u> lbs./ft. Dia. <u>6</u> in. to <u>0</u> ft. depth Wall Thickness: inches or Dia. <u>6</u> in. to <u>32</u> ft. depth gage No. <u>132</u>	
10. Screen: Manufacturer's name <u>Sunflower</u> Type <u>RMP</u> Dia. <u>10"</u> Slope gauze <u>3/16</u> Length <u>5 FT</u> Set between <u>27</u> ft. and <u>32</u> ft. Gravel pack? <u>No</u> Size range of material	
11. Static water level: <u>19</u> ft. below land surface Date <u>7-6-76</u> mo./day/yr.	
12. Pumping level below land surfaces: <u>19</u> ft. after <u>1</u> hrs. pumping <u>15</u> g.p.m. <u>0</u> ft. after <u>0</u> hrs. pumping <u>0</u> g.p.m. Estimated maximum yield <u>50</u> g.p.m.	
13. Water sample submitted: <u>Yes</u> <input checked="" type="checkbox"/> No <input type="checkbox"/> Date	
14. Well head completion: <u>12</u> Pitless adapter <u>12</u> Inches above grade	
15. Well grouted? <u>Yes</u> With: <u>Neat cement</u> <u>Bentonite</u> <input checked="" type="checkbox"/> Concrete Depth: From <u>0</u> ft. to <u>11</u> ft.	
16. Nearest source of possible contamination: <u>10</u> ft. Direction <u>SE</u> Type <u>Fluvial</u> Well disinfected upon completion? <u>Yes</u> <input checked="" type="checkbox"/> No <input type="checkbox"/>	
17. Pump: Not installed Manufacturer's name <u>SEARS</u> Model number <u>27</u> HP <u>1/2</u> Volts <u>220</u> Length of drop pipe <u>27</u> ft. capacity <u>20</u> g.p.m. Type: <input checked="" type="checkbox"/> Submersible <input type="checkbox"/> Turbine <input type="checkbox"/> Jet <input type="checkbox"/> Reciprocating <input type="checkbox"/> Centrifugal <input type="checkbox"/> Other	
18. Elevation: Topography: <input checked="" type="checkbox"/> Hill <input type="checkbox"/> Slope <input type="checkbox"/> Upland <input checked="" type="checkbox"/> Valley	
19. Remarks: (Use a second sheet if needed)	
20. Water well contractor's certification: This well was drilled under my jurisdiction and this report is true to the best of my knowledge and belief. <u>Protheroe Pump & Htg</u> Business name <u>27</u> License No. <u>27</u> Address <u>Wichita</u> Signed <u>Protheroe</u> Date <u>7-7-76</u> Authorized representative	

Forward the white, blue and pink copies to the Department of Health and Environment

Form WWC-5