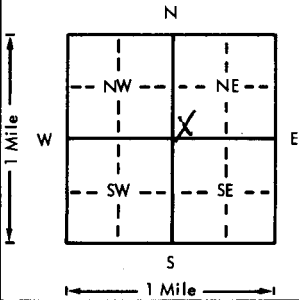



USE TYPEWRITER OR BALL  
POINT PEN-PRESS FIRMLY,  
PRINT CLEARLY.

WATER WELL RECORD  
KSA 82a-1201-1215

Kansas Department of Health and  
Environment-Division of Environment  
(Water well Contractors)  
Topeka, Kansas 66620

1. Location of well:		County <u>Sedgwick</u>	Fraction <u>SW 1/4 SW 1/4 NE 1/4</u>	Section number <u>30</u>	Township number <u>T 27 S</u>	Range number <u>R 15 E/W</u>
2. Distance and direction from nearest town or city: Street address of well location if in city: <u>846 S. VINE</u>				3. Owner of well: <u>G. MERTES</u> R.R. or street: <u>846 S. VINE</u> City, state, zip code: <u>WINSTON, KS.</u>		
4. Locate with "X" in section below:		Sketch map:		6. Bore hole dia. <u>11</u> in. Completion date <u>5-15-79</u> Well depth <u>26</u> ft.		
				7. Cable tool <input type="checkbox"/> Rotary <input type="checkbox"/> Driven <input type="checkbox"/> Dug <input type="checkbox"/> Hollow rod <input type="checkbox"/> Jetted <input checked="" type="checkbox"/> Bored <input type="checkbox"/> Reverse rotary <input type="checkbox"/>		
5. Type and color of material				From	To	8. Use: Domestic <input type="checkbox"/> Public supply <input type="checkbox"/> Industry <input type="checkbox"/> Irrigation <input type="checkbox"/> Air conditioning <input type="checkbox"/> Stock <input type="checkbox"/> <input checked="" type="checkbox"/> Lawn <input type="checkbox"/> Oil field water <input type="checkbox"/> Other <input type="checkbox"/>
<u>Topsoil</u>				<u>0</u>	<u>10</u>	9. Casing: Material <u>PVC</u> Height: Above or below Threaded <input type="checkbox"/> Welded <input type="checkbox"/> Surface <u>12</u> in. RMP <input checked="" type="checkbox"/> PVC <input type="checkbox"/> Weight <u>2.750</u> lbs./ft. Dia. <u>5</u> in. to <u>26</u> ft. depth Wall Thickness: inches or Dia. <u>5</u> in. to <u>26</u> ft. depth gage No. <u>1258</u>
<u>Sand FINE</u>				<u>11</u>	<u>15</u>	10. Screen: Manufacturer's name <u>Modern Pipe Co.</u> Type <u>PVC</u> Dia. <u>5.563</u> Slot/gauze <u>.025</u> Length <u>5</u> Set between <u>21</u> ft. and <u>26</u> ft. _____ ft. and _____ ft. Gravel pack? <u>No</u> Size range of material _____
<u>Sand MED.</u>				<u>16</u>	<u>20</u>	11. Static water level: _____ mo./day/yr. <u>16</u> ft. below land surface Date <u>5-15-79</u>
<u>GRAVEL - COARSE</u>				<u>21</u>	<u>26</u>	12. Pumping level below land surfaces: <u>16</u> ft. after <u>1</u> hrs. pumping <u>20</u> g.p.m. _____ ft. after _____ hrs. pumping _____ g.p.m. Estimated maximum yield <u>507</u> g.p.m.
						13. Water sample submitted: _____ mo./day/yr. Yes <input checked="" type="checkbox"/> No <input type="checkbox"/> Date _____
						14. Well head completion: _____ Pitless adapter <u>12</u> inches above grade
						15. Well grouted? <u>Yes</u> With: <u>Neat cement</u> Bentonite _____ Concrete _____ Depth: From <u>0</u> ft. to <u>10</u> ft.
						16. Nearest source of possible contamination: ft. <u>55</u> Direction <u>SE</u> Type <u>SPURTA</u> Well disinfected upon completion? <input checked="" type="checkbox"/> Yes <input type="checkbox"/> No
						17. Pump: <input checked="" type="checkbox"/> Not installed Manufacturer's name _____ Model number _____ HP _____ Volts _____ Length of drop pipe _____ ft. capacity _____ g.p.m. Type: _____ Submersible _____ Turbine _____ Jet _____ Reciprocating _____ Centrifugal _____ Other _____
(Use a second sheet if needed)						
18. Elevation:		19. Remarks:		20. Water well contractor's certification: This well was drilled under my jurisdiction and this report is true to the best of my knowledge and belief. <u>2157 Electric</u> <u>129</u> Business name _____ License No. _____ Address <u>512 W. 21st</u> Signed <u>J. Harris</u> <u>5-30-79</u> Authorized representative _____ Date _____		
Topography: _____ Hill _____ Slope _____ Upland <input checked="" type="checkbox"/> Valley						

Forward the white, blue and pink copies to the Department of Health and Environment

Form WWC-5