

1	LOCATION OF WATER WELL: County: SEDGWICK	Fraction NW ¼ SW ¼ SW ¼	Section Number 31	Township Number T 27 S	Range Number R 1 E E/W
---	---	----------------------------	----------------------	---------------------------	---------------------------


Distance and direction from nearest town or city street address of well if located within city?

2331 N. Grant Rd., Wichita, Ks.

2	WATER WELL OWNER:	Bill Todd	
	RR#, St. Address, Box # :	2331 N. Grant Rd.	Board of Agriculture, Division of Water Resources
	City, State, ZIP Code :	Wichita, Ks.	Application Number:

3 LOCATE WELL'S LOCATION WITH AN "X" IN SECTION BOX: 4 DEPTH OF COMPLETED WELL... 90 ... ft. ELEVATION: ...

WELL'S STATIC WATER LEVEL ... 30 ... ft. below land surface measured on mo/day/yr 6/2/81

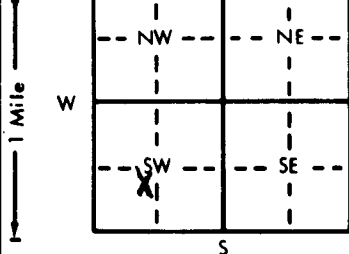

4 DEPTH OF COMPLETED WELL 90 ft. ELEVATION:
Depth(s) Groundwater Encountered 1. 72 ft. 2. ft. 3. ft.
WELL'S STATIC WATER LEVEL 30 ft. below land surface measured on mo/day/yr 6/2/81

Pump test data:	Well water was	ft. after	hours pumping	gpm
Est. Yield	gpm: Well water was	ft. after	hours pumping	gpm
Bore Hole Diameter	11 in. to	ft., and	in. to	ft.

WELL WATER TO BE USED AS:			
1 Domestic	3 Feedlot	6 Oil field water supply	9 Dewatering
2 Irrigation	4 Industrial	7 Lawn and garden only	10 Observation well
			11 Injection well
			12 Other (Specify below)
			

Was a chemical/bacteriological sample submitted to Department? Yes.....No.....**X**.....; If yes, mo/day/yr sample was submitted
Water Well Disinfected? Yes **X** No

5	TYPE OF BLANK CASING USED:			CASING JOINTS: Glued . ☒ . Clamped	
	1 Steel	3 RMP (SR)	5 Wrought iron	8 Concrete tile	Welded
	2 PVC	4 ABS	6 Asbestos-Cement	9 Other (specify below)	Threaded
			7 Fiberglass		

Blank casing diameter	5.	in. to	40	ft., Dia		in. to	6	ft. Dia	Cer Mac Styrene	in. to	SDR-26		ft.
Casing height above land surface	12	in., weight	1.59	lbs./ft.	Wall thickness or gauge No.							203	

TYPE OF SCREEN OR PERFORATION MATERIAL:			7 PVC	10 Asbestos-cement
1 Steel	3 Stainless steel	5 Fiberglass	8 RMP (SR)	11 Other (specify)
2 Brass	4 Galvanized steel	6 Concrete tile	9 ABS	12 None used (open hole)

SCREEN OR PERFORATION OPENINGS ARE:		5 Gauzed wrapped	<u>8 Saw cut</u> .06	11 None (open hole)
1 Continuous slot	3 Mill slot	6 Wire wrapped	9 Drilled holes	
2 Louvered shutter	4 Key punched	7 Torch cut	10 Other (specify)	

SCREEN-PERFORATED INTERVALS:	From 40 ft. to 90 ft.,	From ft. to ft.
	From ft. to ft.,	From ft. to ft.
GRAVEL PACK INTERVALS:	From 14 ft. to 90 ft.,	From ft. to ft.
	From ft. to ft.,	From ft. to ft.

6 GROUT MATERIAL:		1 Neat cement	2 Cement grout	3 Bentonite	4 Other
Grout Intervals:	From	40" ft.	to 14 ft.	From	ft. to ft. to ft.

What is the nearest source of possible contamination:

1 Septic tank	4 Lateral lines	7 Pit privy	10 Livestock pens	14 Abandoned water well
2 Sewer lines	5 Cess pool	8 Sewage lagoon	11 Fuel storage	15 Oil well/Gas well
3 Watertight sewer lines	6 Seepage pit	9 Feedyard	12 Fertilizer storage	16 Other (specify below)
			13 Insecticide storage	
Direction from well? Northeast			How many feet? 55	

[illegible]

7 CONTRACTOR'S OR LANDOWNER'S CERTIFICATION: This water well was (1) constructed, (2) reconstructed, or (3) plugged under my jurisdiction and was completed on (mo/day/year) 6/2/81 and this record is true to the best of my knowledge and belief. Kansas

Water Well Contractor's License No. 236 This Water Well Record was completed on (mo/day/yr) 7-31-81
under the business name of Harp Well & Pump Serv., Inc. by (signature) M. Arnold
INSTRUCTIONS: Use typewriter or ball point pen, PLEASE PRESS FIRMLY and PRINT clearly. Please fill in blanks, underline or circle the correct answers. Send top three copies to Kansas Department of Health and Environment, Division of Environment, Environmental Geology Section, Topeka, KS 66620. Send one to WATER WELL OWNER and retain one for your records.